

1. PURPOSE

1.1 To provide instructions on proper equipment to be utilized, and procedures and precautions to be followed to insure safety during a hydrostatic test.

2. GENERAL

2.1 The Supervisor in charge of the installation shall be responsible for the hydrostatic testing. All personnel involved with the hydrostatic test must be familiar with the test procedure, and safety precautions to be followed during the hydrostatic test.

3. SAFETY CONSIDERATIONS

3.1 Take precautions as necessary to protect employees and the general public during testing. These shall include, but are not limited to the following:

3.1.1 Locate the test equipment and instrumentation a safe distance from the test section. (See Gas Standard A-37.1)

3.1.2 Keep personnel not working on the test operation out of the test area.

3.1.3 Place barriers along the test section where appropriate to prevent public access.

3.1.4 Notify parties located in the general vicinity of the test section to avoid the area during the test.

3.1.5 Patrol and use flagmen to keep people away during testing.

3.2 Visually inspect temporary piping, closures, and other equipment used in conjunction with the test to verify that they are in safe working order. Maintain a periodic visual inspection of this equipment from a safe distance during the test.

3.3 Do not remove caps, plugs, or valves from the test head, or any other test equipment, until a positive determination is made from two independent taps that the test section is depressurized.

37.6

Notify public agencies of the scheduled test, and when necessary;

3.1.6 Schedule the test at a time that will minimize public exposure in highly populated areas.

APPROVED BY										
DSH										
RA										
TEL										
1/1/77										
REV.	DATE	DESCRIPTION				GM	DWN.	CHKD.	SUPV.	APVD.
GM		PIPING - DATA SHEET HYDROSTATIC TESTING PROCEDURE GAS STANDARD PACIFIC GAS AND ELECTRIC COMPANY SAN FRANCISCO, CALIFORNIA				B/M				
SUPV.						DWG. LIST				
DSGN.						SUPSDS				
DWN.						SUPSD BY				
CHKD.						SHEET NO. 1 OF 8 SHEETS				
O.K.						REV.				
DATE	SCALE					086870				
4-24-79										
62-1804 Rev 7-75						MICROFILM				

4. TEST PROCEDURE

4.1 Establish a plan for the hydrotest. As appropriate, this shall include detailed written instructions covering problem areas for the specific test involved. These shall be developed by the engineer responsible for the test, in conjunction with the supervisor on the test.

4.1.1 Consider the potential for flooding, or other damage should a failure occur.

4.1.2 Consider the safety of ~~occupants of nearby buildings.~~ ^{company personnel and the general public.}

4.1.3 Have a copy of the Strength Test Pressure Report and schematic sketch of the test section at the test location.

4.2 Prepare a sketch of the test section showing stationing of the test section and points of maximum and minimum elevation. (See Gas Standard A-37.2).

5. OBTAIN PROPER TEST EQUIPMENT

5.1 Test Heads

5.1.1 The General Construction-Gas Department is responsible for the construction and maintenance of all test heads. Pages 6 to 8 of this Standard lists all test heads authorized for use to date. Test heads not on this list shall not be used until they have been inspected and issued serial numbers by the General Construction-Gas Department.

5.1.2 Test heads are to be constructed in accordance with Gas Standard A-37.1, Drawing No. 386527. All test heads must be visually inspected, X-rayed, hydrostatically tested, properly tagged for maximum test pressure, and issued serial numbers before they are authorized for use. The necessary ~~paperwork~~ ^{to verify the inspection and testing and} to verify the wall thickness, size and grade of pipe and fittings used to make each test head shall be on file with General Construction in Oakland.

5.1.3 Test heads shall be requested from General Construction-Gas Department, 4930 Colliseum Way, Oakland 94601, [REDACTED] Company Phone [REDACTED] as far in advance as possible. In some instances, when a new test head must be fabricated, the lead time may be as long as 6 to 8 months. Expenses for newly fabricated test heads, and their shipment to and from the requesting location, will be charged to the construction GM. The proper job number and accounting will be required with the request.

PG & E CO.

DRAWING NUMBER REV.

SHEET 2 OF 8 SHEETS

086870

MICROFILM

- 5.1.4 If the proper size test heads are not available for a test, substitute test heads may be used with the approval of Gas System Design Department. Due to the unequal O.D. and W.T. of the pipe to be tested and the substitute test heads, Gas System Design Department will determine the proper installation procedures for these test heads.
- 5.1.5 For the safety of personnel, the protection of the test head and ease of shipment, special steel skids have been made for each test head. Care must be taken in placing the test head on the skid. ~~Most will fit in only one direction, which allows~~ for the proper placement of the chains. Improper mounting could result in an injury, or damage to the test head.
- 5.1.6 Modifications, welding or cutting shall not be made in the field (except welding the test head to the pipe being tested). If modifications are required, the test head must be returned to General Construction-Gas Department in Oakland for the modifications.
- 5.1.7 All test heads shall be returned to General Construction-Gas Department in Oakland immediately after completion of the test. All test heads must be returned with the same valves, plugs, caps and nipples intact.
- 5.1.8 A pup of tested pipe may be left on the test head only if it is: (a) relatively close to the same grade and wall thickness of the test head, and (b) clearly marked with the grade, wall thickness, and pressure to which it was tested. This information must also be on the shipping notice when returning the test head.
- 5.1.9 A shipping notice must accompany each test head that is being returned or relocated to another job site.
- 5.2 Pigs, spheres, scrapers, etc., for use on a job, must be properly sized for the largest internal diameter of the test section or test head. When necessary, use scraper cups, discs, or polyurethane pigs for post test pipeline cleaning. Gas Standard A-37.3 illustrates typical manufacturer's instructions for filling and sizing a sphere.
- 5.3 Test Instruments
- 5.3.1 Pressure recorders are required on all hydrostatic tests. The recorders must be calibrated every six months. If both a dead weight tester and a pressure recorder are used on a hydrotest, adjust the pressure recorder to read

For most test heads, there is only one mounting position which will allow

PG & E CO.	DRAWING NUMBER	REV.
	086870	
SHEET 3 OF 8 SHEETS	MICROFILM	

~~3.1 Water Supply Survey:~~

8. Water Supply

8.1 The water used for testing shall be reasonably clean. Contaminated water or salt water shall not be used. Water shall be obtained from the most readily available source, subject to authorizations by the appropriate local, county, state or federal regulating agency or agencies.

8.2 If wells must be used as the water source and the quantity of water needed for the test is substantial a draw-down test shall be performed. If the wells prove to be inadequate an alternate source should be found. Transporting water by truck shall be used only as a last resort when the quantity of water needed is substantial.

the same as the dead weight tester before beginning the test. A chart with the proper pressure scale and time interval must be used.

5.3.2 Dead weight testers must be calibrated within the last 12 months by the General Construction, Gas, Measurement and Control Section located at 25051 O'Neil Avenue, Hayward, California 94544, phone [REDACTED] Company phone [REDACTED] A dead weight tester is required when testing over 90% SMYS of any segment of the test section.

5.3.3 Indicating pressure gauges should be available for possible installation at the remote end of the test section, or at maximum or minimum elevations of the test section. These gauges are for information purposes only.

5.4 Pressurizing equipment, hoses, and other associated equipment must be checked out and be in good working condition before the test. Make sure the equipment is properly sized and rated for the maximum test pressure.

6. VERIFY THE STRENGTH TEST PRESSURE REPORT

6.1 If Part I of the Strength Test Pressure Report does not show the latest design changes on the design drawings, or the actual pipe to be tested, return the Strength Test Pressure Report to the Project Engineer or Gas System Design for necessary corrections (the Gas Estimators' Manual and the Gas Foremans' Manual give complete instruction on the Strength Test Pressure Report).

7. NOTIFICATION OF HYDROTEST

7.1 For work assigned to General Construction, notify the General Office-Gas Construction Department seven days prior to the date the hydrotest is scheduled.

7.2 If work is performed by the Division, notify the Gas System Design Department seven days prior to the date of hydrotest.

7.3 If the job was reported to the CPUC, it is likely that the hydrotest will be witnessed by a member of the CPUC Staff and Gas System Design Department.

8. WATER ^{Filling} SUPPLY (See Gas Standard A-37.4 for Typical Set-up)

8.1 Make sure the following points are considered in the water filling operation:

	PG & E CO.	DRAWING NUMBER	REV.
	SHEET 4 OF 8 SHEETS	086870	
		MICROFILM	

8.1.1 The test section must be completely filled with water. A pig must be run ahead of the water to force as much air as possible out of the test section. For test sections where a pig cannot be used, the air must be vented at the high points.

8.1.2 Fill the test section from only one direction.

8.1.3 If necessary, anchor or support the pipe to prevent excessive stress levels caused by the weight of the water. Special consideration should be given to bridge crossings and spans.

8.1.4 *Open and close fill and drain valves slowly to prevent pressure surges resulting from rapid changes in water velocity.*

8.2 Water Filling Equipment

8.2.1 Size the fill pumps considering static head due to elevation difference in the test section, and the fill time desired.

8.2.2 Install filters on the suction line to prevent fish and other foreign matter from entering the test section.

8.2.3 The exhaust of the pump engine must have spark arrestors.

8.2.4 Water may be transferred from one test section to another by use of a hairpin. (See Gas Standard A-37.5). The hairpin shall not be left in place during the test.

10. WATER REMOVAL (See Gas Standard A-37.7 for Typical Set-up)

10.1 Use extreme caution when releasing water at the test pressure. The pressure should be relieved by partially opening a small tap valve before opening the main dewatering valve.

10.2 Remove the water from long test sections by pigging. *The most effective speed of a pig for dewatering is considered to 1 to 5 miles per hour.*

10.3 Where removal of moisture is critical, use two pigs with a slug of methanol between them.

10.4 Short sections may be inclined to drain, and swabbed dry by hand.

10.5 Dispose of the water in a manner that will prevent damage to the environment and comply with any water disposal regulations.

10. REPORTS

10.1 The Gas Estimators' Manual and the Gas Foremans' Manual contain sections that provide complete instruction on the completion of the Strength Test Pressure Report. Completed reports must be signed, and all copies for distribution must be clear and show all pertinent data.

	PG & E CO.	DRAWING NUMBER	REV.
	SHEET 5 OF 8 SHEETS	086870	
		MICROFILM	

TEST HEADS AUTHORIZED FOR USE

<u>DIAMETER</u>	<u>SERIAL No.</u>	<u>GRADE</u>	<u>W.T.</u>	<u>MAXIMUM TEST PRESSURE</u>
3"	3761	"B"	.216"	2160
3"	3761-A	"	"	"
4" Comb.	4761-A	"B"	.237"	2160
4" Comb.	4761-B	"	"	"
4"	4791-A	"	"	"
4"	4791-B	"	"	"
4"	4792-A	"	"	"
4"	4792-B	"	"	"
6"	6761-A	X-52	.500"	2160
6"	6761-B	"	"	"
6"	6762-A	"B"	.432"	2738
6"	6762-B	"	"	"
6"	6791-A	"	"	2160
6"	6791-B	"	"	"
8" Comb.	8761-A	"B"	.500"	2160 w/4" Heads
8" Comb.	8761-B	"	"	"
8"	8791-A	"	"	2160
8"	8791-B	"	"	"
8"	8792-A	"	"	"
8"	8792-B	"	"	"
10"	10761	X-52	.500"	2160
10"	10761-A	"	"	"
10"	10762-A	"B"	"	1627
10"	10762-B	"	"	1953
10"	10763-A	X-52	.365"	1765
10"	10763-B	"	"	"

PG & E CO.		DRAWING NUMBER	REV.
SHEET 6 OF 8 SHEETS		086870	
		MICROFILM	

<u>DIAMETER</u>	<u>SERIAL No.</u>	<u>GRADE</u>	<u>W.T.</u>	<u>MAXIMUM TEST PRESSURE</u>
12"	12751-A	X-52	.500"	2039
12"	12751-B	"	"	"
12"	12752-A	"	"	"
12"	12752-B	"	"	"
12"	12763-A	"	"	"
12"	12763-B	"	"	"
16"	16751	X-52	.500"	1625
16"	16752	"	"	"
16"	16753	"	"	"
16"	16753-A	"	"	"
16"	16753-B	"	"	"
16"	16753-C	"	"	"
16"	16764-A	"	"	"
16"	16764-B	"	"	"
16"	16765-A	"	"	"
16"	16765-B	"	"	"
16"	16766-A	"	.680"	2160
16"	16766-B	"	"	"
18"	18761-A	X-52	.500"	1733
18"	18761-B	"	"	"
20"	20761-A	X-42	.750"	1440
20"	20761-B	"	"	"
20"	20762-A	X-52	.500"	1560
20"	20762-B	"	"	"
22"	22761-A	Y-60	1.000"	3853
22"	22761-B	"	"	3853

P G & E CO.

DRAWING NUMBER REV.

SHEET 7 OF 8 SHEETS



086870

MICROFILM

<u>DIAMETER</u>	<u>SERIAL NO.</u>	<u>GRADE</u>	<u>W.T.</u>	<u>MAXIMUM TEST PRESSURE</u>
24"	24761-A	X-52	.625"	1440
24"	24761-B	"	"	"
24"	24762-A	"	.750"	1950
24"	24762-B	"	"	"
26"	26761-A	Y-52	.750"	1772
26"	26761-B	"	"	"
26"	26762-A	"	"	"
26"	26762-B	"	"	"
34"	34761-A	X-52	1.000"	1835
34"	34761-B	"	"	"
36"	36761-A	X-60	.750"	1440
36"	36761-B	"	"	"
36"	36762-A	"	.730"	"
36"	36762-B	"	"	"

P G & E CO.		DRAWING NUMBER	REV.
SHEET 8 OF 8 SHEETS		086870	
		MICROFILM	

1 2 3 4 5 6 7 8 9 10

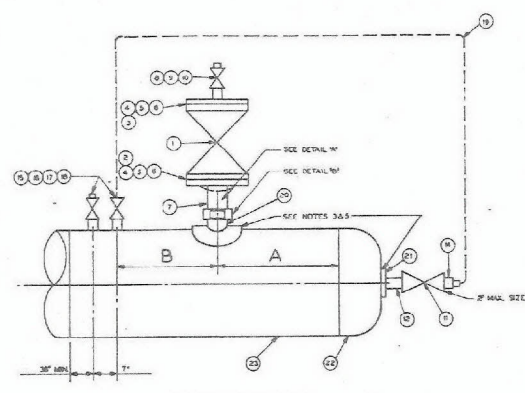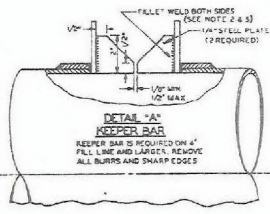

MATERIAL SPECIFICATION CHART				DESIGN INFORMATION			
MOUL SIZE (F91)	GRADE	WALL THICKNESS (IN)	MAX. ALLOWED WORKING PRESSURE (PSIG)	PIPE	GRADE	WALL THICKNESS (IN)	MAX. ALLOWED WORKING PRESSURE (PSIG)
4	35,000	0.283	8.0	2	2	0.283	2460
6	35,000	0.406	8.0	2	2	0.406	2150
8	35,000	0.530	8.0	2	2	0.530	1850
10	35,000	0.654	8.0	2	2	0.654	1550
12	35,000	0.777	8.0	2	2	0.777	1250
14	35,000	0.901	8.0	2	2	0.901	950
16	35,000	1.024	8.0	2	2	1.024	650
18	35,000	1.148	8.0	2	2	1.148	350
20	35,000	1.271	8.0	2	2	1.271	50
22	35,000	1.395	8.0	2	2	1.395	0
24	35,000	1.518	8.0	2	2	1.518	0
26	35,000	1.642	8.0	2	2	1.642	0
28	35,000	1.765	8.0	2	2	1.765	0
30	35,000	1.889	8.0	2	2	1.889	0
32	35,000	2.012	8.0	2	2	2.012	0
34	35,000	2.136	8.0	2	2	2.136	0
36	35,000	2.259	8.0	2	2	2.259	0

1. THE PIPE USED TO FABRICATE TEST HEADS MUST MEET API 5L OR BULK SPECIFICATIONS. THE CAPS USED TO FABRICATE TEST HEADS MUST HAVE THE SAME S.W.Y.S. AND WALL THICKNESS AS THE PIPE USED.

2. THE GENERAL TEST HEADS ARE DESIGNED TO OPERATE AT A MAXIMUM OF 0.5 DIVE. HOWEVER, DUE TO DESIGN STRESS LIMITATIONS ON PAD REINFORCEMENT FOR FILL VALVE CAP, NOMINAL SIZE OF TEST HEADS ARE DESIGNED FOR USE AT A MAXIMUM OF 0.3 DIVE (SEE BOX SIZE A-37). F IS A DESIGN FACTOR BASED ON THE FACT THAT PAD REINFORCEMENT MUST BE USED AT THE FILL VALVE-SEE NOTE 3.

3. BOX S.W.Y.S. OF TEST HEAD (P=2(D_oE_tS.W.Y.S._{II}) AND MAX. TEST PRESSURE (P=2(E_tS.W.Y.S._I)P OR RATING OF NEAREST FITTING).

4. MUST BE RECALCULATED FOR ANY S.W.Y.S. OR WALL THICKNESS OTHER THAN THOSE SPECIFIED IN THIS CHART - SEE NOTES 6 AND 10.


- NOTES:**
- FOR TEST PRESSURES HIGHER THAN THOSE SHOWN IN THE TABLE, CONSULT GAS SYSTEM DESIGN DEPARTMENT.
 - WELDING MUST BE IN ACCORDANCE WITH GAS STANDARD D-22. PARTICULAR ATTENTION SHOULD BE GIVEN TO THE FOLLOWING ITEMS:
 - USE THE LOW HYDROGEN WELDING PROCESS WHEN THE WALL THICKNESS OF THE TEST HEAD MATERIAL EXCEEDS 0.400" AND MATERIAL THICKNESS, 120% WALL THICKNESS. THE TEST HEAD MUST BE STRESS RELIEVED.
 - WHEN INSTALLING TEST HEAD ON A GAS MAIN WITH A DIFFERENT SIZE, THE WELDING PROCEDURE QUALIFIED FOR THE HIGHER WELD PIPE MUST BE USED.
 - THE SAME PRECATHING PROCEDURES ARE TO BE USED BEFORE REMOVING THE TEST HEAD AS WERE USED BEFORE INSTALLING IT.
 - DO NOT LOCATE WELLS OR REINFORCING RINGS CLOSER THAN 6" TO ANY WELD OR TO EACH OTHER.
 - REINFORCING RINGS MUST BE CONSTRUCTED IN ACCORDANCE WITH GAS STANDARD A-50.
 - ALL Girth WELDS ARE TO BE RADIOGRAPHICALLY INSPECTED.
 - ALL FILLET WELDS MUST BE VISUALLY INSPECTED BY A QUALIFIED COMPANY INSPECTOR.
 - THE TEST HEAD MUST BE HYDROSTATICALLY TESTED TO BOX SIZE FOR 8 HOURS BEFORE BEING USED. VALVES & FLANGES 2" AND LARGER MUST NOT BE CONNECTED TO THE TEST HEAD DURING THIS HYDROSTATIC TEST. TEST HEAD NIPPLES (LETTERS T & L2) MUST HAVE ADDITIONAL LENGTH TO ALLOW FOR EXTRA HEAVY CAPS TO BE ATTACHED DURING THE TEST.
 - THE FOLLOWING INFORMATION MUST BE RETAINED IN THE GENERAL OFFICE, GENERAL CONSTRUCTION GAS DEPARTMENT OFFICE, FOR THE LIFE OF EACH TEST HEAD:
 - ALL PURCHASING DOCUMENTS FOR ORIGINAL AND REPAIR MATERIALS.
 - ALL STRENGTH TEST PRESSURE REPORTS FOR THE TEST HEAD, BOTH ORIGINAL AND RETESTS.
 - ALL RADIOGRAPHIC INSPECTION REPORTS, BOTH ORIGINAL AND RETESTS.
 - A VISUAL INSPECTION FOR DAMAGE MUST BE MADE OF EACH TEST HEAD PRIOR TO ITS USE AND ANY DAMAGE MUST BE REPAIRED. THE REPAIR OF SOME TYPES OF DAMAGE WILL REQUIRE A REQUALIFICATION HYDROSTATIC TEST OF THE TEST HEAD AND 48 HOURS. THE DECISION TO REHYDROSTATICALLY TEST MUST BE MADE BY THE TEST SUPERVISOR AND CLEARED THROUGH THE GENERAL OFFICE, GENERAL CONSTRUCTION GAS DEPARTMENT.
 - IF THE WALL THICKNESS OF THE PIPE TO BE TESTED IS NOT BETWEEN 1/32" OF THE TEST HEAD PIPE WALL THICKNESS, REFER TO GAS STANDARD D-22 FOR PROPER INSTALLATION OF TRANSITION PIECES.
 - GAS SYSTEM DESIGN DEPARTMENT MUST BE CONSULTED FOR ANY DEVIATIONS FROM THIS DRAWING.
 - ALL PIPING TEST HEADS SHALL BE BUILT BY THE GENERAL CONSTRUCTION GAS DEPARTMENT.

ITEM	QUANTITY	DESCRIPTION	REMARKS
1	1	VALVE, ROCKWELL FIG 2344, ANSI 500, SCRD ENDS, 2"	SEE NOTE ON DWG.
2	1	VALVE, BALL ANST, 500, FLANGED ENDS, 4"	SEE NOTE ON DWG.
3	1	"	SEE NOTE ON DWG.
4	1	FLANGE, ANST, 500, IN-W	BORED TO S. 625 ± 0.015
5	1	"	BORED TO S. 625 ± 0.015
6	1	BLIND FLANGE, ANST 500, DRILLED TAP 1/4" N.P.T., 4"	BORED TO T. 1.49 ± 0.015
7	1	"	SEE NOTE ON DWG.
8	1	GASKET, TOSCAL, ANST 500, P.T. NO. 04581-500-610, 4"	SEE NOTE ON DWG.
9	1	"	SEE NOTE ON DWG.
10	16	NUT, STUO, ASTH-A-191, 1/8" X 1/8" X 6-1/2"	SEE NOTE ON DWG.
11	24	"	SEE NOTE ON DWG.
12	24	"	SEE NOTE ON DWG.
13	32	40 NUT, ASTH-A-194, 3/8" X 3/8" X 1/2"	SEE NOTE ON DWG.
14	1	WIPPLE, GR. B, 6.5" O.D. X 0.216" T. FOC 224"	SEE NOTE ON DWG.
15	1	"	SEE NOTE ON DWG.
16	1	"	SEE NOTE ON DWG.
17	1	VALVE, ABDQ, MTC-2, 5000 PSIG, 1/4" X 1/4"	SEE NOTE ON DWG.
18	1	PLUG, STEEL, 3000# OR BETTER, 1/4"	SEE NOTE ON DWG.
19	1	NIPPLE, GR. B, 6.5" O.D., E.H., 3.0" E.L.	SEE NOTE ON DWG.
20	1	VALVE, ROCKWELL FIG 2344, ANST 500, SCRD ENDS, 2"	SEE NOTE ON DWG.
21	1	WIPPLE, GR. B, 6.5" O.D., E.H., 3.0" E.L.	SEE NOTE ON DWG.
22	1	BUSSING, STEEL, 3000# OR BETTER, 3" X 1/2"	SEE NOTE ON DWG.
23	2	VALVE, ABDQ, MTC-40, 5000 PSIG, 1/2" X 1/2"	SEE NOTE ON DWG.
24	2	"	SEE NOTE ON DWG.
25	2	WIPPLE, GR. B, 6.5" O.D., E.H., 3.0" E.L.	SEE NOTE ON DWG.
26	2	WIPPLE, GR. B, 6.5" O.D., E.H., 3.0" E.L.	SEE NOTE ON DWG.
27	2	SOCK-O-LET, 3000#, 1/2" X (CAMBER PIPE DIAMETER)	SEE NOTE ON DWG.
28	1	HOSE, HIGH PRESSURE, RUBBER WALE SPIRAL ENDS, 1/2"	SEE NOTE ON DWG.
29	1	REINFORCING PAD, PIPE, 6" X (CAMBER PIPE DIAMETER), G.S. A-50	SEE NOTE ON DWG.
30	1	"	SEE NOTE ON DWG.
31	1	REINFORCING PAD, PIPE, 6" X (CAMBER PIPE DIAMETER), G.S. A-50	SEE NOTE ON DWG.
32	1	REINFORCING PAD, CAP, 6" X (CAP SIZE), G.S. A-50	SEE NOTE ON DWG.
33	1	CAP, TO SUIT, 6" X (CAP SIZE), G.S. A-50	SEE NOTE ON DWG.
34	1	PIPE, TO SUIT, 6" X (CAP SIZE), G.S. A-50	SEE NOTE ON DWG.

BILL OF MATERIAL

(Handwritten notes and stamps are present in this section, including a large "366527" stamp.)

A-37.1

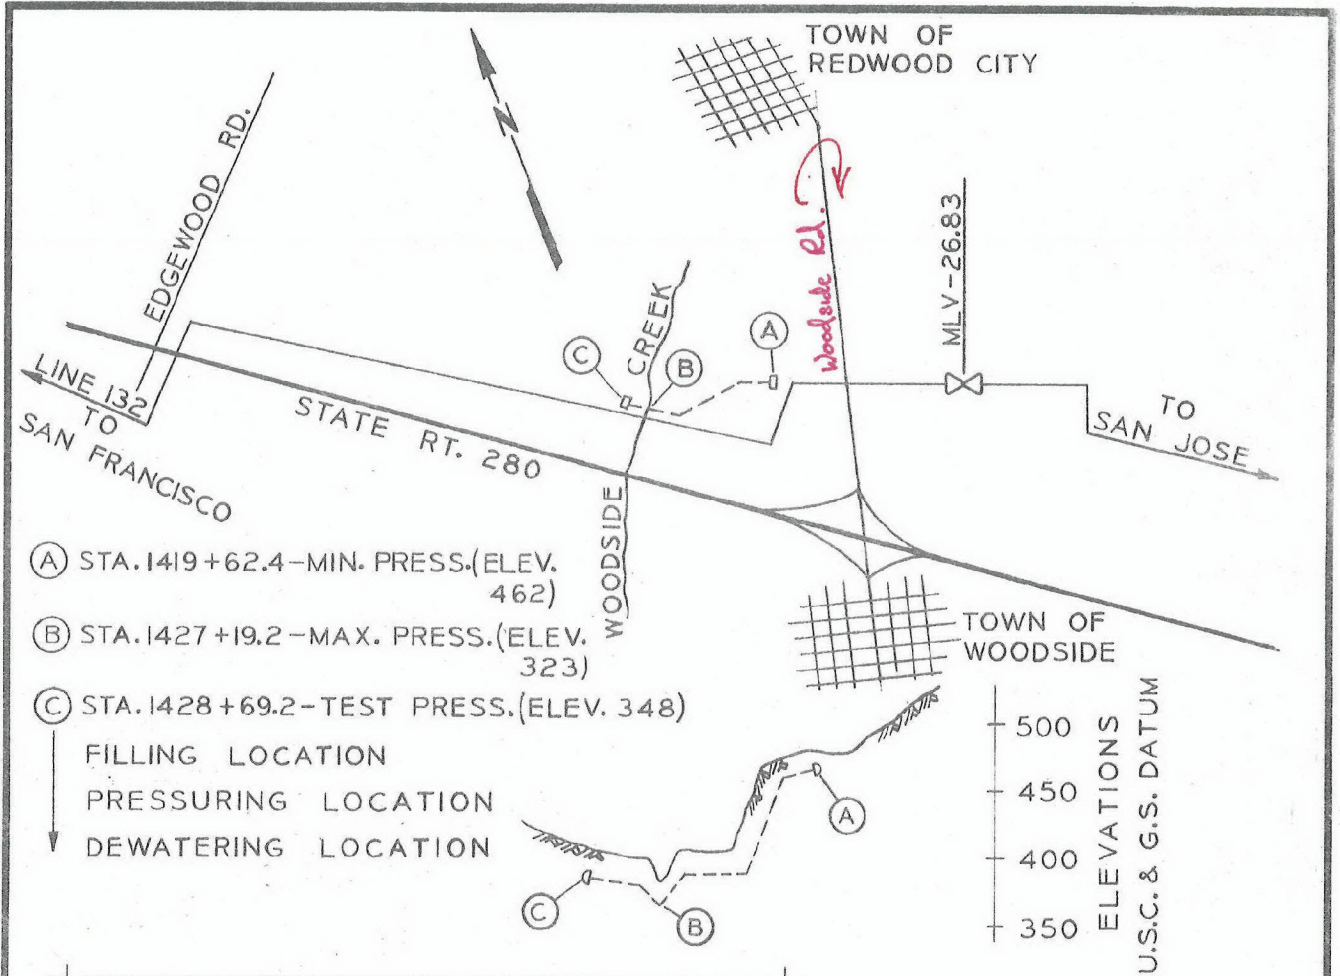

- (A) STA. 1419+62.4 - MIN. PRESS. (ELEV. 462)
 - (B) STA. 1427+19.2 - MAX. PRESS. (ELEV. 323)
 - (C) STA. 1428+69.2 - TEST PRESS. (ELEV. 348)
- ↓ FILLING LOCATION
 ↓ PRESSURING LOCATION
 ↓ DEWATERING LOCATION

500
 450
 400
 350
 ELEVATIONS
 U.S.C. & G.S. DATUM

RELOCATE SECTION OF 24" LINE 132
 SAN JOSE DIV. PENINSULA DIST.
 TOWN OF WOODSIDE (INCORP.)

REF. DWG. B-7621
 REF. DWG. 483619 SH.1&2


STATE OF CALIF. B.M. - 1" BRASS DISK LOCATED IN A.C. BERM ON
 S/W CORNER OF WOODSIDE RD. & ACCESS
 ROAD TO P.G. & E. CO. WOODSIDE STA.
 (ELEV. 457.27)

APPROVED BY							
GM							
SUPV.							
DSGN.							
DWN.							
CHKD.							
O.K.							
DATE	SCALE	PIPELINE-SCHEMATIC SAMPLE OF HYDROSTATIC TEST SKETCH GAS STANDARD PACIFIC GAS AND ELECTRIC COMPANY SAN FRANCISCO, CALIFORNIA				B/M DWG. LIST SUPSDS SUPSD BY SHEET NO.	
4-18-79						086872	
						SHEETS REV.	
						MICROFILM	

NOTE: THESE INSTRUCTION ARE SPECIFICALLY FOR SPHERES MANUFACTURED BY THE F.H. MALONEY CO. MANUFACTURER'S LITERATURE SHOULD BE CONSULTED FOR OTHER BRANDS OF SPHERES.

Filling instructions

4"

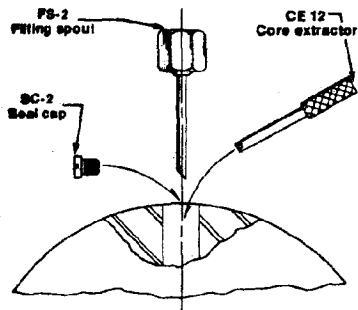

To fill a sphere it is necessary to follow this sequence:


1. With a screwdriver remove seal cap (SC-2).
2. Remove valve core with core extractor (CE-12).
3. Using the filling spout (FS-2) or a small funnel, fill sphere completely.

NOTE:

It may be necessary to tap sphere to remove trapped air during this operation.

4. Replace valve core with core extractor (CE-12).

Sizing instructions

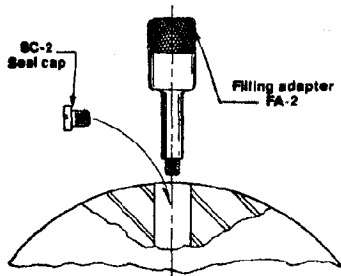

To size a sphere it is necessary to follow this sequence:

1. Hand tighten filling adapter (FA-2) to sphere valve.
2. Thread filling adapter (FA-2) into quick coupling on pressure pump.
3. Inflate sphere to proper size.
4. Remove filling adapter (FA-2) from sphere valve.
5. Replace seal cap (SC-2).

For efficient operation, spheres must be filled with liquid and sized to proper diameter.

Recommended liquid fillers for pipeline spheres	
Temperature range	Liquid filler
Below 32°F	50% Ethylene glycol and water
32°F - 150°F	Water
Above 150°F	Glycerol
CAUTION Do not use hydrocarbon filling liquids	

Sphere sizing recommendations

Recommendations are intended as a guide only. Actual experience will allow more accurate sizing for any given line under actual operating conditions. Urethane - 1% larger than pipe ID. All other compounds - 2% larger than pipe ID.

Required tools and accessories

- Pressure pump
- Filling adapter
- Valve wrench
- Filling spout
- Core extractor


Optional tools, parts and accessories

Description

1. Replacement valve core (all spheres).
2. Replacement valve - spheres 6" and larger (complete with valve body, core, cap, and "O" ring).
3. Replacement caps
4. Radioactive source container.
5. Sizing rings (per customer specifications).

Filling instructions

6" thru 42"

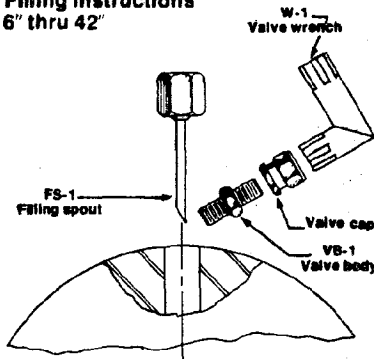

To fill a sphere it is necessary to follow this sequence:


1. Remove valve cap with small end of valve wrench (W-1).
2. Remove valve body (VB-1) with large end of valve wrench (W-1).
3. Using the filling spout (FS-1) or a small funnel, fill sphere completely.

NOTE:

It may be necessary to tap sphere to remove trapped air during this operation.

4. Replace valve body (VB-1) with valve wrench (W-1).

Sizing instructions

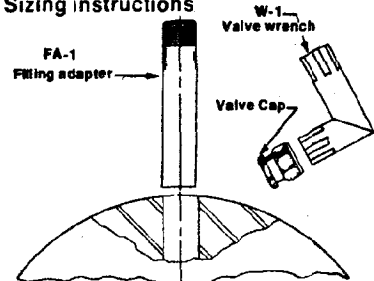

To size a sphere it is necessary to follow this sequence:

1. Hand tighten filling adapter (FA-1) to sphere valve.
2. Thread filling adapter (FA-1) into quick coupling on pressure pump.
3. Inflate sphere to proper size.
4. Remove filling adapter (FA-1) from sphere valve.
5. Replace valve cap with valve wrench (W-1).

APPROVED BY

WJH
RIA
TJA

REV. DATE DESCRIPTION GM DWN. CHKD. SUPV. APVD.

GM
SUPV.
DSGN.
DWN.
CHKD.
O.K.
DATE 4-18-79 SCALE

PIPING - DATA SHEET
FILLING AND SIZING INSTRUCTION FOR
PIPELINE SPHERE
GAS STANDARD
PACIFIC GAS AND ELECTRIC COMPANY
SAN FRANCISCO, CALIFORNIA

B/M
DWG. LIST
SUPSDS
SUPSD BY
SHEET NO. 1 OF 2 SHEETS
086873
REV.
MICROFILM

GENERAL DESCRIPTION

The pressure pump is designed to facilitate the filling and sizing of Maloney Pipeline Spheres in permanent and temporary installations.

The pump is a single acting, positive displacement, hand operated unit capable of pressures up to approximately 300 p.s.i. Effective volume is approximately four cubic inches per stroke. Both suction and discharge sides are equipped with check valves, and a manual pressure relieving valve is included on the discharge side. The suction side of the pump is piped to standard 1/4-inch IPS threads with a removable hard rubber reservoir.

The complete unit includes the pump, reservoir, pressure discharge hose with quick coupling fitting, and one quick coupling adapter to fit the sphere filling adapters.

ACCESSORIES

Available as accessories for this pump are:

- a. Pressure gauge kit (includes 0-400 p.s.i. gauge, and necessary tee and nipple), not installed.
- b. Drain hose, with hose clamp.
- c. Extra quick coupling adapters, one included with pump, to fit sphere filling adapters.


None of the above are required for the proper operation of the pump, but may be required for convenience.

OPERATION

To fill and size a sphere it is necessary to follow this sequence:

1. With the valve wrench, remove the entire valve from the sphere.
2. Using the filler spout or a small funnel, fill the sphere completely with water. (It may be necessary to tap the sphere to remove trapped air during this operation.)
3. Replace the valve in the sphere and tighten firmly (with 4" spheres only the valve core is removable).
4. Hand tighten the filling adapter (FA-1 or FA-2) to the sphere valve.
5. Remove the quick coupling from the pressure hose end and thread it into the filling adapter.
6. Fill the reservoir with liquid. (Consult your Maloney representative for the proper liquid to use in unusual temperature applications.) Water is preferred.
7. Operate the pump until all air is evacuated from the pump and hose.

NOTE: THESE INSTRUCTIONS ARE SPECIFICALLY FOR SPHERES AND PUMPS MANUFACTURED BY THE F.H. MALONEY CO. MANUFACTURER'S LITERATURE SHOULD BE CONSULTED FOR OTHER BRANDS OF SPHERES AND PUMPS.

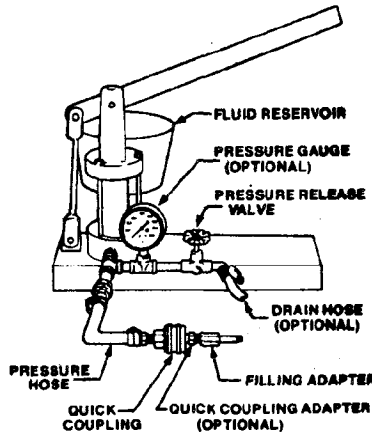

8. Recouple the hose filling adapter and proceed to inflate sphere to proper diameter.
 9. After reaching proper size, the pressure may be relieved from the filler hose with the small hand valve.
 10. Remove the filling adapter from the sphere valve.
 11. Replace the valve cap firmly.
- The only precautions necessary in inflating the sphere are as follows:
- a. Make sure that all air is evacuated from the sphere during filling and inflating.
 - b. Tighten valve and valve caps firmly, but do not force threads.
 - c. In the event of valve leakage replace the entire valve assembly in the sphere.


MAINTENANCE

In normal use the pump requires no maintenance other than a few drops of oil on the roll pin bushings. For long periods of storage it would be advisable to pump a clean mineral oil through the pump before packaging.

HOW TO ORDER

The pressure pump for pipeline spheres is furnished with the necessary fittings up to the valve filling adapter. Specify on order "Pressure pump complete". The filling adapter and the various accessories listed for use with the pump must be ordered separately as needed.

APPROVED BY										
<i>[Signature]</i>	<i>[Signature]</i>									
REV.	DATE	DESCRIPTION				GM	DWN.	CHKD.	SUPV.	APVD.
GM	SUPV.	PIPING-DATA SHEET FILLING AND SIZING INSTRUCTION FOR PIPELINE SPHERE GAS STANDARD PACIFIC GAS AND ELECTRIC COMPANY SAN FRANCISCO, CALIFORNIA				B/M	DWG. LIST	SUPSDS	SUPSD BY	SHEET NO. 2 OF 2 SHEETS
DSGN.	DWN.					REV.	086873			
CHKD.	O.K.									
DATE	SCALE									
4-18-79										
62-1804 Rev 7-75						MICROFILM				

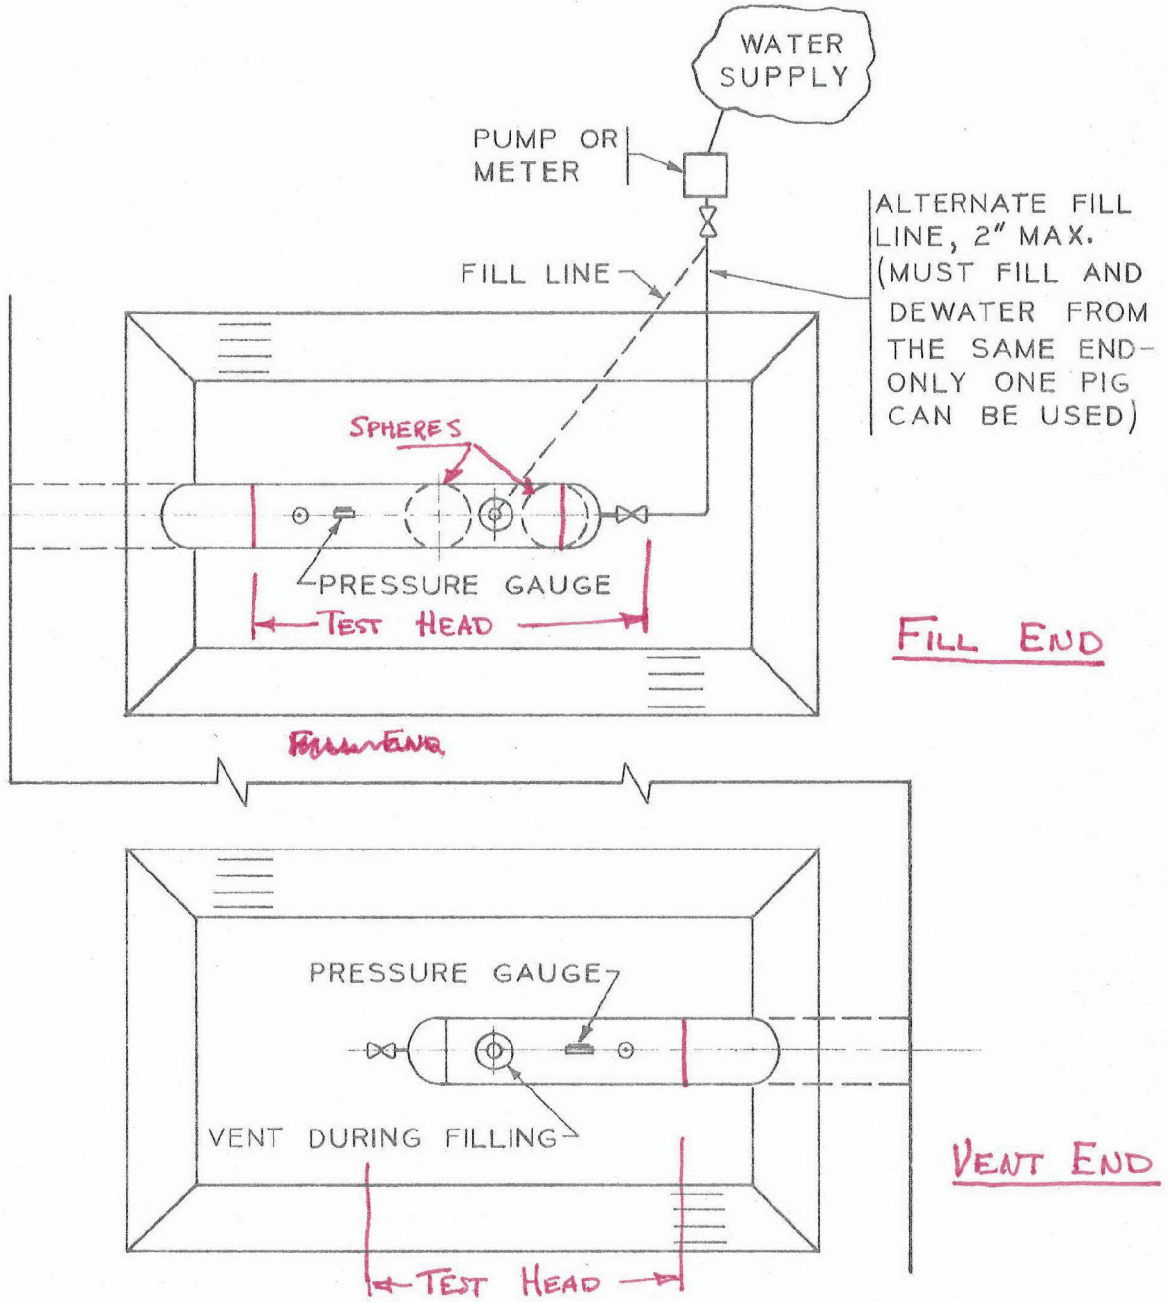


APPROVED BY																
[Signature]																
[Signature]																
[Signature]																
	REV.	DATE	DESCRIPTION								GM	DWN.	CHKD.	SUPV.	APVD.	
GM																
SUPV.																
DSGN.																
DWN.																
CHKD.																
O.K.																
DATE	SCALE														B/M	
4-18-79															DWG. LIST	
															SUPSDS	
															SUPSD BY	
															SHEET NO.	SHEETS
															086874	REV.
															MICROFILM	

62-1804 Rev 7-75

PIPING - SCHEMATIC
HYDROSTATIC TEST-SAMPLE FOR FILLING
GAS STANDARD
PACIFIC GAS AND ELECTRIC COMPANY
SAN FRANCISCO, CALIFORNIA

MICROFILM

NOTE: MANIFOLDS ARE FOR THE TRANSFER OF WATER FROM ONE TEST SECTION TO ANOTHER. MANIFOLDS ARE NOT TO BE IN PLACE DURING A HYDROSTATIC TEST.

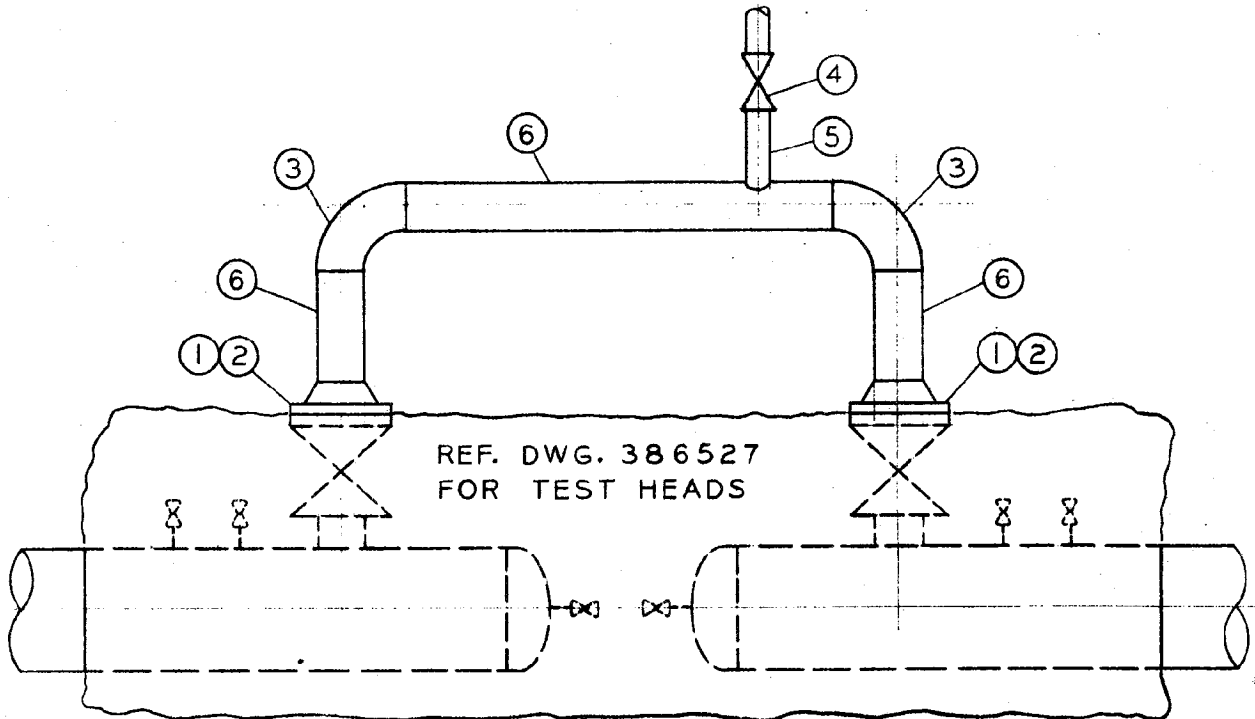

REF. DWG. 386527
FOR TEST HEADS

- * S₁ = TEST HEAD 14"-16"
- S₂ = TEST HEAD 18"-30"
- S₃ = TEST HEAD 32"-36"

ITEM	QTY.			DESCRIPTION	REMARKS
	S ₁	S ₂	S ₃		
1	2			FLANGE, ANSI 900, WN., R.F. 4"	BORED TO 4.026"
		2		FLANGE, ANSI 900, WN., R.F. 6"	BORED TO 5.761"
			2	FLANGE, ANSI 900, WN., R.F. 8"	BORED TO 7.625"
2	2			GASKET, ISOSEAL, ANSI 900 4"	
		2		GASKET, ISOSEAL, ANSI 900 6"	
			2	GASKET, ISOSEAL, ANSI 900 8"	
3	2			ELBOW, 90°, L.R., STD., GR. B 4"	
		2		ELBOW, 90°, L.R., STD., GR. B 6"	
			2	ELBOW, 90°, L.R., STD., GR. B 8"	
4	1	1	1	VALVE, ROCKWELL FIG. 2344, ANSI 900 2"	SCREWED
5	1	1	1	NIPPLE, SMLS. STL., GR. B, E.H., T.O.E. 2" x 6"	
6	*			PIPE, SMLS. STL., GR. B, 4.5" x 0.237" W.T.	* CUT TO SUIT
		*		PIPE, SMLS. STL., GR. B, 6.625" x 0.432" W.T.	* CUT TO SUIT
			*	PIPE, SMLS. STL., GR. B, 8.625" x 0.500" W.T.	* CUT TO SUIT

APPROVED BY


[Handwritten signatures]

REV.	DATE	DESCRIPTION	GM	DWN.	CHKD.	SUPV.	APVD.


GM	
SUPV.	
DSGN.	
DWN.	
CHKD.	
O.K.	
DATE	SCALE
4-18-79	

PIPING - DETAILS
HYDROSTATIC TEST MANIFOLD (HAIRPIN)
GAS STANDARD
PACIFIC GAS AND ELECTRIC COMPANY
SAN FRANCISCO, CALIFORNIA

B/M	
DWG. LIST	
SUPSDS	
SUPSD BY	
SHEET NO.	
	SHEETS
	REV.
086875	

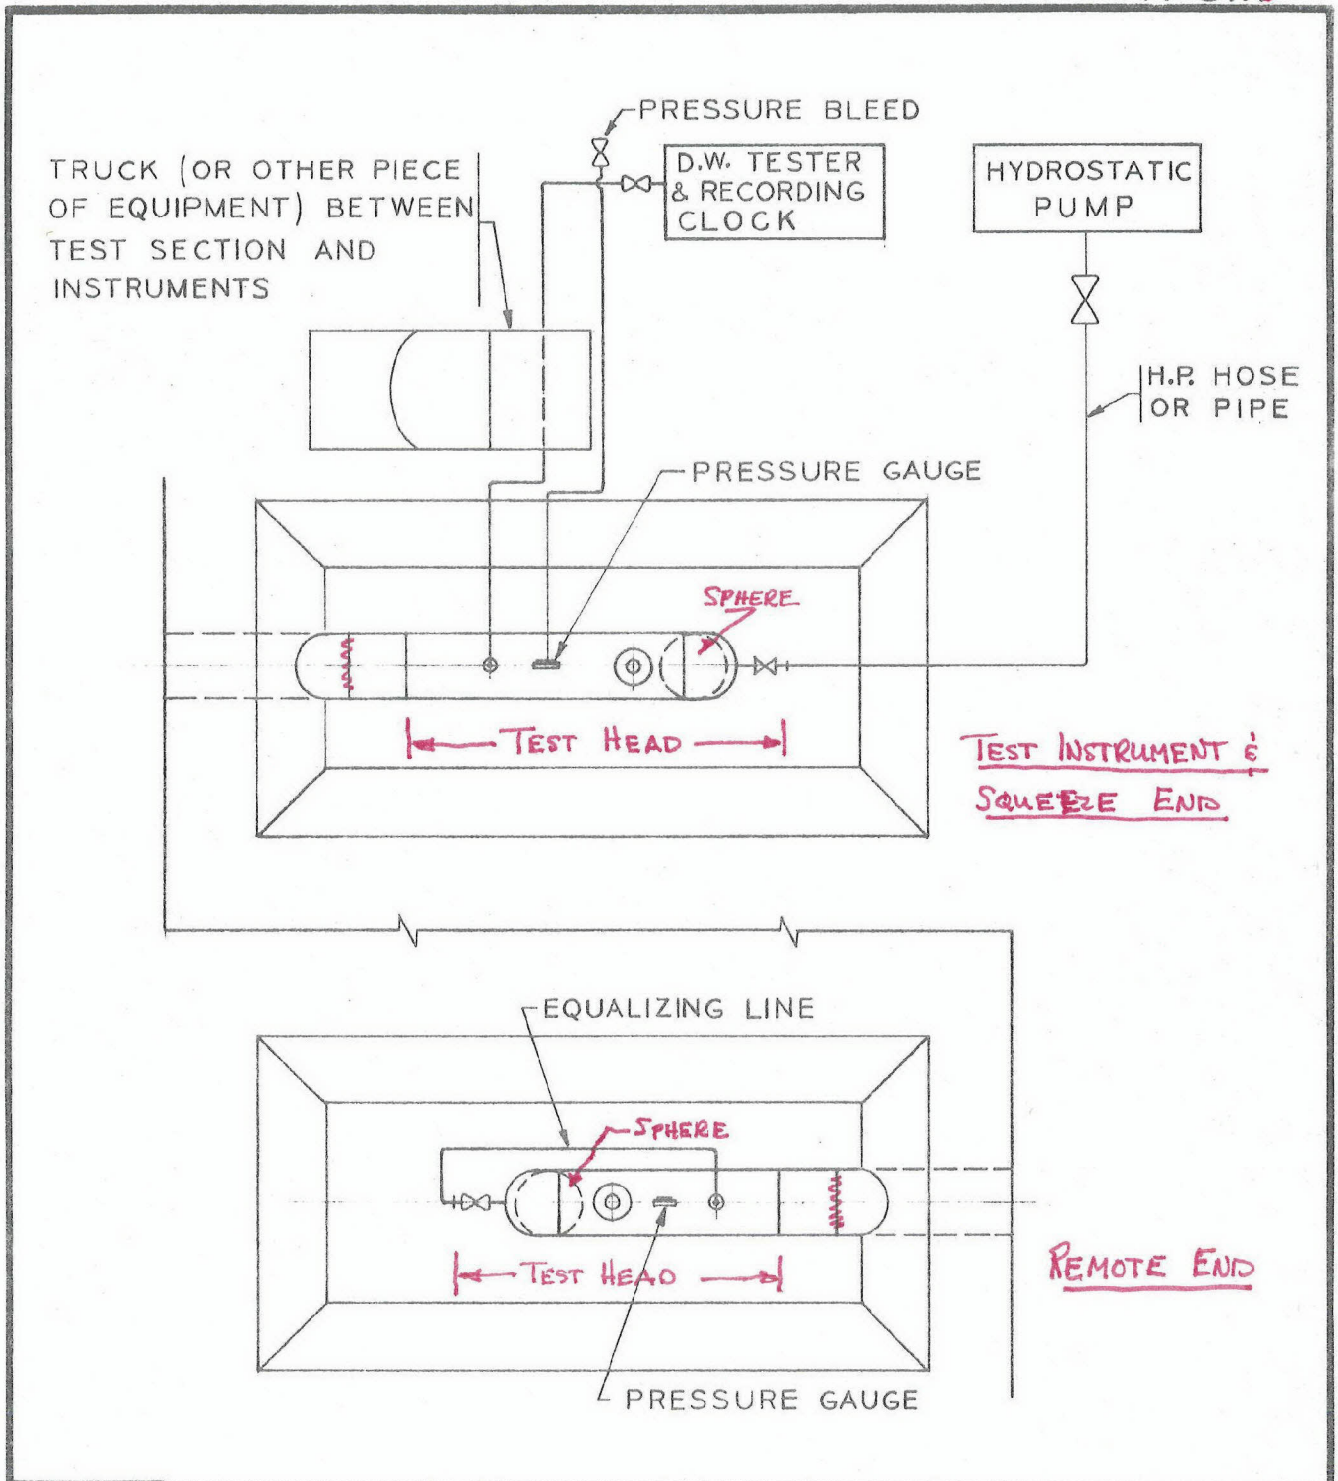

APPROVED BY										
REV.	DATE	DESCRIPTION				GM	DWN.	CHKD.	SUPV.	APVD.
GM		PIPING-SCHMATIC HYDROSTATIC TEST SAMPLE SET UP FOR SQUEEZE GAS STANDARD PACIFIC GAS AND ELECTRIC COMPANY SAN FRANCISCO, CALIFORNIA				B/M				
SUPV.						DWG. LIST				
DSGN.						SUPSDS				
DWN.						SUPSD BY				
CHKD.						SHEET NO.		SHEETS	REV.	
O.K.		086871								
DATE	SCALE									
4-18-79										
62-1804 Rev 7-75						MICROFILM				

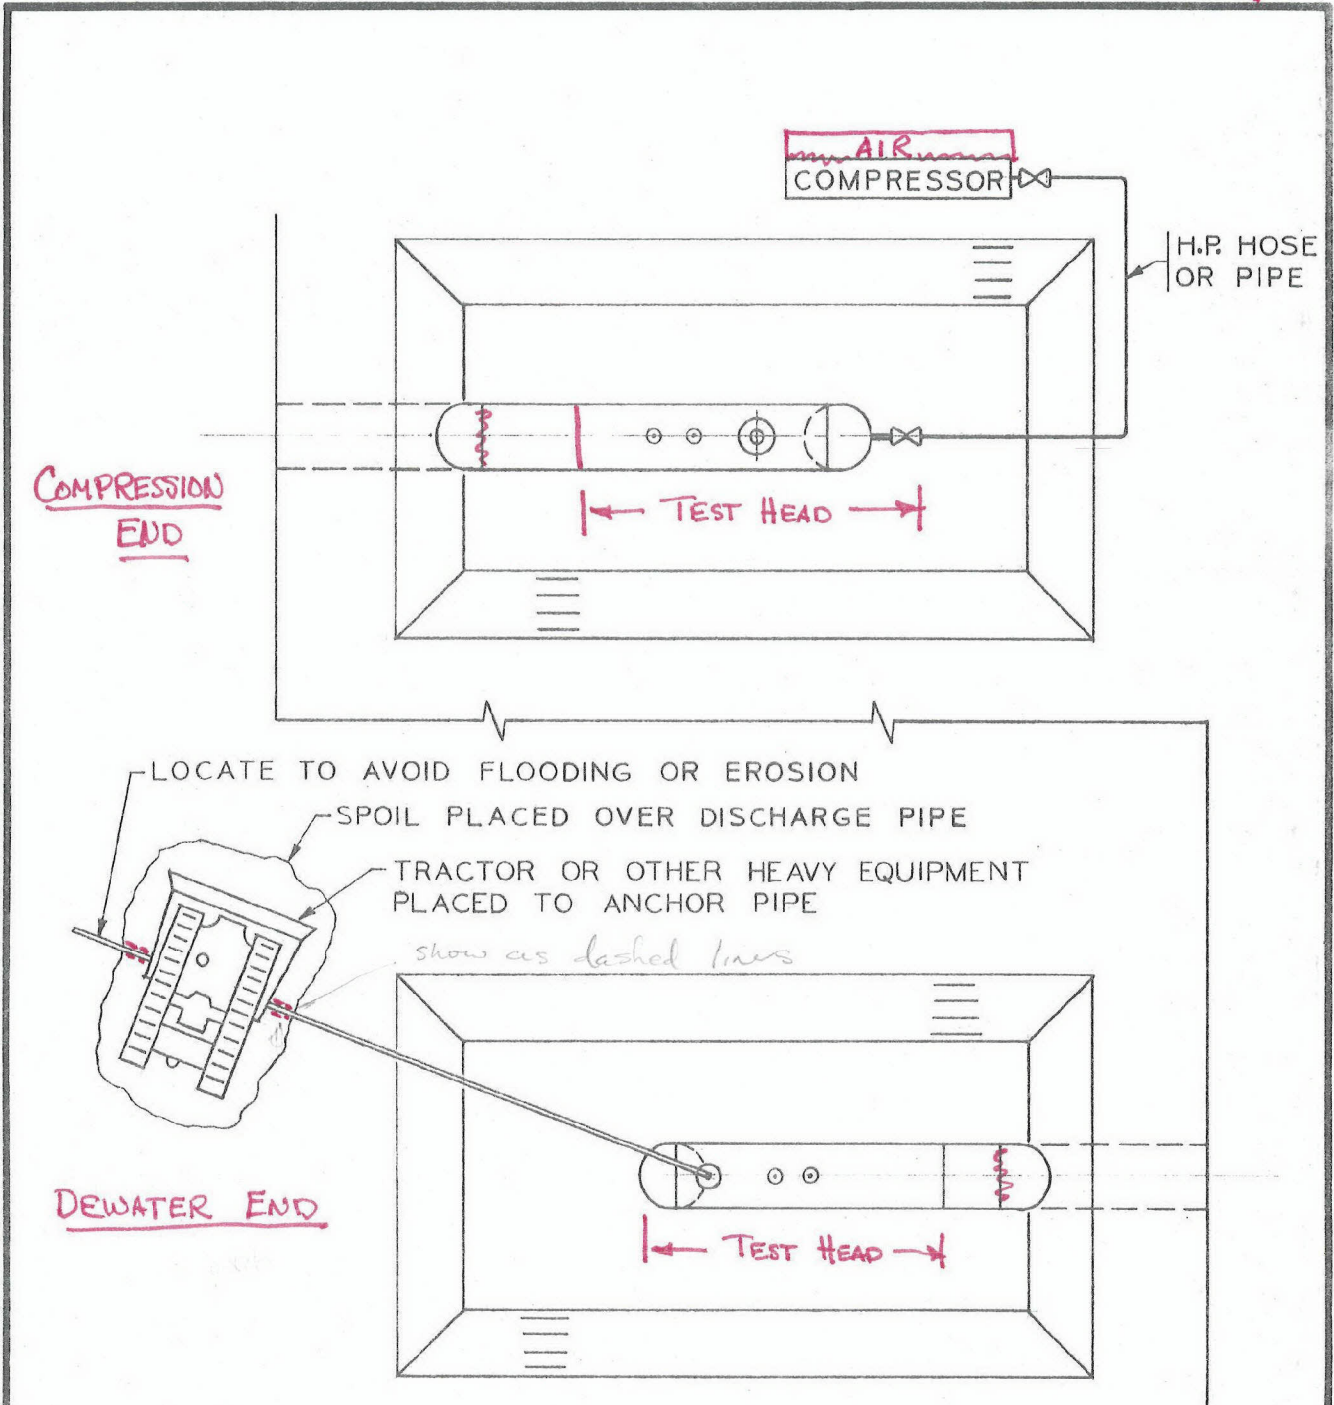

APPROVED BY																				
GM	SUPV.																			
DSGN.																				
DWN.																				
CHKD.																				
O.K.																				
DATE	SCALE																			
4-18-79																				
PIPING - SCHEMATIC HYDROSTATIC TEST-SAMPLE FOR DEWATERING GAS STANDARD PACIFIC GAS AND ELECTRIC COMPANY SAN FRANCISCO, CALIFORNIA										B/M DWG. LIST SUPSDS SUPSD BY SHEET NO. 086876 SHEETS REV.										
62-1804 Rev 7-75										MICROFILM										