

1.0 GENERAL

- 1.1 A welder qualified under this standard may perform arc welding on all API 5L, 5LX, ASTM A53 or A-106 grades of pipe up to and including X60. This would include all natural gas lines designed to operate at stress levels of 20% or more of the specified minimum yield strength to comply with CPUC General Order 112-~~C~~.
- 1.2 The standard definitions contained in API Standard 1104, latest edition referenced in Appendix "A" of General Order 112-~~C~~, shall apply to this standard.

LATEST EDITION  
LATEST EDITION

2.0 QUALIFICATION TEST

- 2.1 Before any production welding is performed on pipelines or components designed to operate at over 20% of SMYS, welders shall be qualified under this section. The weld shall meet the visual inspection requirements of Par. 4, Standard D-40 and shall also be qualified by either the radiographic testing requirements of Section 2.0, Standard D-31, (for butt welds only), or the destructive testing requirements of Section 3.0 and/or 4.0, Standard D-31.

2.1.1 The test shall be made on steel pipe - 12-3/4" O.D. x ~~0.250"~~ or greater wall, any grade.

HORIZONTAL

2.1.1.1 Butt Weld - The welder shall make a butt weld in the fixed position with the axis of the pipe either in the horizontal plane or inclined from the horizontal plane at an angle not exceeding 45° (See Page 4).

2.1.1.2 Branch Connection - The welder shall lay out, cut, fit, and weld a full size branch on pipe connection. The weld shall be made with the run pipe axis in the horizontal position and the branch pipe axis extending vertically downward from the run (see Page 5).

Pls. do not assume not have to be fixed.

2.2 Scope of Qualification

- 2.2.1 A welder who has successfully completed the qualification tests under Section 2.1.1 shall be qualified to weld on natural gas pipelines designed to operate at any stress level, in all positions, on all wall thicknesses, joint designs, including fillet welds, and fittings on all pipe diameters and all grades of pipe if the essential variables in Section 2.3 remain unchanged. Qualification under Section 2.1.1 by destructive testing is required before

1	10-11-77	ADDED FORM 75-292 & PAR. 2.6	2/A				
0	1-20-77	Issue for use	2/A	2-6-79	REVISED PARA 2.6		
CHG.	DATE	DESCRIPTION	APPRD.	CHG.	DATE	DESCRIPTION	APPRD.
APPROVED		<p>BY _____</p> <p>DSGN. _____</p> <p>DR. _____</p> <p>CH. _____</p> <p>O.K. _____</p> <p>DATE 11-18-76</p> <p>SCALE _____</p>				<p>PIPING - DATA SHEET</p> <p>ARC WELDER QUALIFICATION</p> <p>FOR OVER 20% OF SMYS</p> <p>GAS STANDARD</p> <p>PACIFIC GAS AND ELECTRIC COMPANY</p>	
SUPERSEDES		SUPERSEDED BY		SHEET No. 1 OF 3 SHEETS		DRAWING NUMBER	CHANGE
						086577	2

welding compressor station piping or components.

2.3 If any of the following essential variables are changed, the welder must be requalified:

- 2.3.1 A change from one welding process to any other welding process or combination of welding processes.
- 2.3.2 A change in the direction of welding from vertical up to vertical down or vice versa. (Direction of welding shall be only as allowed by Standard D-22. Refer to Pages 9 and 10, Drawings 084022 and 086462).
- 2.3.3 A change in filler metal from one classification group to another classification group as shown in table below:

FILLER METAL CLASSIFICATION GROUPS

<u>GROUP</u>	<u>AWS SPEC.</u>	<u>ELECTRODE</u>
I	A5.1	EXX 10
	A5.5	EXX 11
II	A5.5	EXX 16 EXX 18

2.4 Requalification of Arc Welders

- 2.4.1 Welders shall be requalified at intervals not exceeding six (6) months. Requalification may consist of successful passing of a radiographic examination of a production butt weld, or by repeating the butt weld test in Section 2.1. If time exceeds 6 months, entire qualification must be repeated.
- 2.4.2 A requalification test, by destructive methods and in accordance with Section 2.1.1.1, may also be required if there is reason to question the welder's ability.
- 2.4.3 Annually, all welders who work on compressor station piping must pass a butt weld test, by destructive methods, in accordance with 2.1.1.1.

2.5 Qualification and requalification tests shall be performed under the supervision of a qualified welding inspector



This inspector shall not leave the immediate area while the testing is being performed. For the purposes of this Standard, a qualified welding inspector is a designated employee that has the experience and knowledge to judge the quality of welds. The supervisor designating the person to inspect the welding for a job has the responsibility to determine that the person is qualified. (See Standard D-40).

	PG & E CO.	DRAWING NUMBER	REV.
	SHEET 2 OF 3 SHEETS	086577	2
		MICROFILM	

2.6 Records

- 2.6.1 Records for all welders who have been qualified under this Standard shall be retained as outlined below.
- 2.6.2 All Employee Qualification and Requalification records must be retained for a minimum duration of five years.
- 2.6.3 All Employee Qualification and Requalification records must be retained through temporary lapses in a welder's qualification.
- 2.6.4 The Record shall be made by filling out Form 75-292 (Gas Standard D-30.2, Page 6).

	PG & E CO.	DRAWING NUMBER	REV.
	SHEET 3 OF 3 SHEETS	086577	2
		MICROFILM	

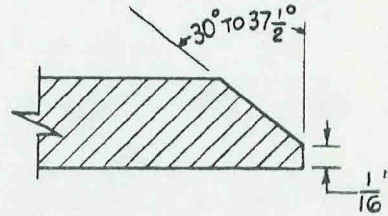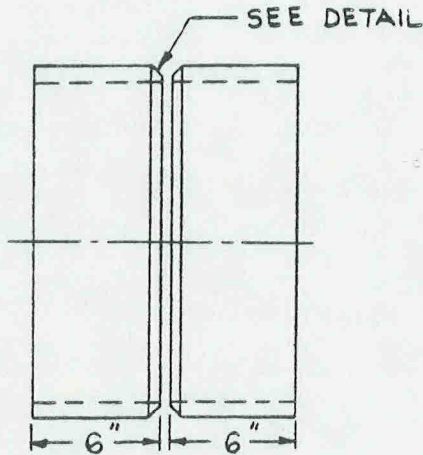

DETAIL OF BEVEL

**NOTES:**

1. SPOOLS CAN BE USED FOR WELDER QUALIFICATION FOR BOTH CELLULOSE COATED (GAS STD. D-22, PG. 9) AND LOW HYDROGEN ELECTRODES (GAS STD. D-22, PG. 10).

**OPERATING INSTRUCTIONS**

(TWO SPOOLS ARE REQUIRED FOR EACH TEST)


SPECIFY:

SPOOL, TEST, 12-3/4" O.D., 0.375" WALL, GR. B,  
6" LENGTH W/30-37.5 DEG. BEVEL ONE END.  
GAS STD. D-30.2, PG&E MFG.

CODE 02-2583

2. REFER TO GAS STD. D-31, PAGE 13, FOR TYPE, NUMBER AND LOCATION OF BUTT WELD TEST SPECIMENS,

APPROVED BY	5	11-30-77	CHANGED STD. PAGE NO. FROM PAGE 3					
	4	12-21-76	REVISED TITLE, TRANSFERRED FROM D-31					
	3	8-17-71	CHANGED SPOOL LENGTH FROM 9" TO 6"					
	7	4-4-83	REVISED NOTES, ADDED ORDERING INSTRUCTIONS					
	6	5-27-80	ADDED NOTES 1 AND 2					
	CHG.	DATE	DESCRIPTION	GM	BY	CH.	APPD.	
SUPV. BY DEPT. OF G.O.	<p align="center"><b>PIPING - DATA SHEET</b></p> BUTT WELD TEST SPOOLS FOR WELDERS WORKING ON PIPE LINES OPERATING AT HOOP STRESSES OF MORE THAN 20% OF THE SPECIFIED MINIMUM YIELD GAS STANDARD PACIFIC GAS AND ELECTRIC COMPANY SAN FRANCISCO, CALIFORNIA			DRAWING LIST SUPERSEDES 083466 SH 5 SUPERSEDED BY SHEET NO. SHEETS DRAWING NUMBER CHANGE 084023 7				
DSGN.								
DR.								
CH.								
O.K.								
DATE	SCALE							
1-4-65	NONE							

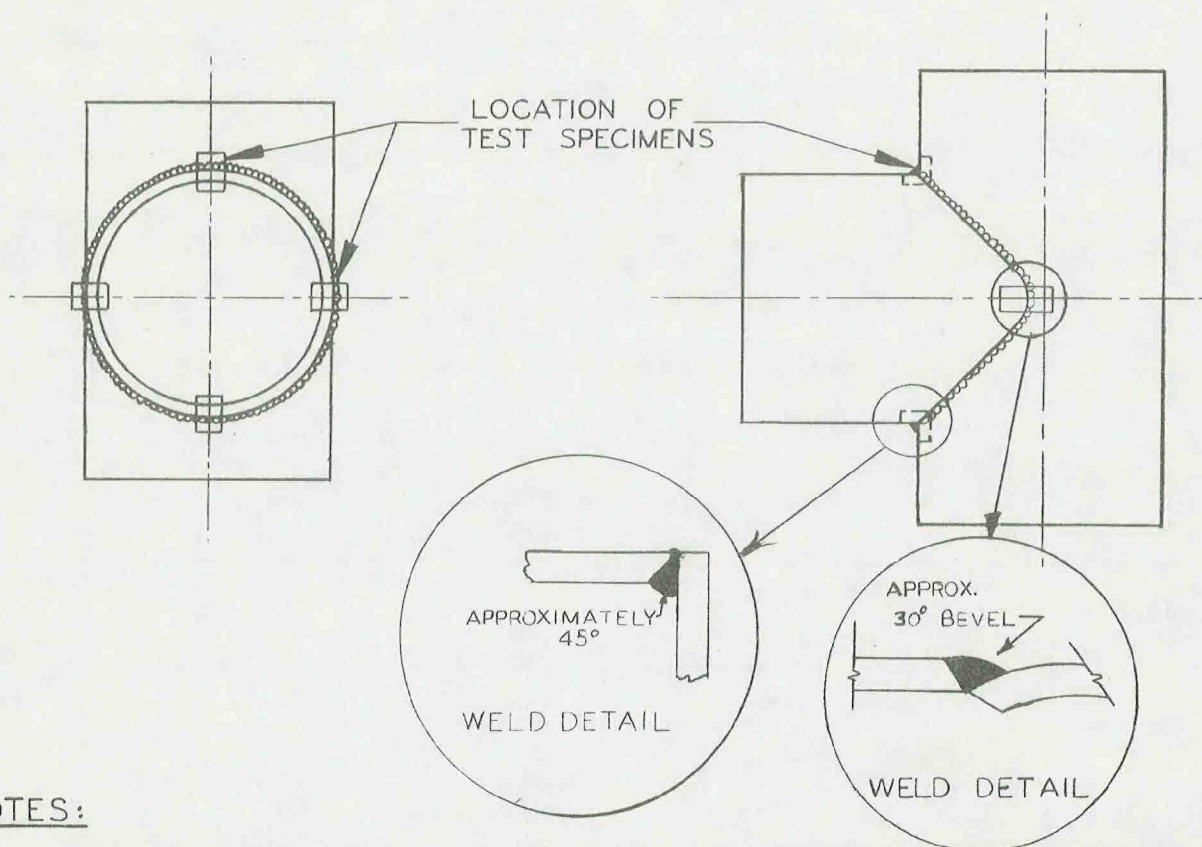

**NOTES:**

1. PIPE IS 12.75" OD X 0.250"-0.375" WALL FOR CELLULOSE COATED ELECTRODES AND 0.375" WALL OR GREATER FOR LOW HYDROGEN ELECTRODES. ANY GRADE LISTED IN PARAGRAPH 1.1 MAY BE USED.
2. WELDER MUST LAYOUT, CUT, FIT AND WELD BRANCH FITTING CONNECTION. A FULL HOLE IS TO BE CUT IN THE RUN. FIXED ✓
3. THE WELD IS TO BE MADE WITH THE RUN PIPE AXIS FIXED ✓ IN THE HORIZONTAL POSITION, AND THE BRANCH PIPE AXIS EXTENDING VERTICALLY DOWNWARD FROM THE RUN.
4. WELD MUST MEET VISUAL TESTING REQUIREMENTS OF SECTION 6.3.
5. FOUR NICK BREAK SPECIMENS ARE REQUIRED. TEST NICK BREAK SPECIMENS FROM LOCATIONS INDICATED. SPECIMENS SHALL MEET REQUIREMENTS OF STANDARD D-31. PREPARE AND BREAK SPECIMENS AS SPECIFIED ON DWG. 084024 (STD. D-31, PAGE 14).

TEST WELD FOR ARC WELDERS QUALIFICATION FOR FACILITIES OPERATING AT OVER 20% OF SMYS.

APPROVED BY	CHG.	DATE	DESCRIPTION	GM	BY	CH.	APPD.
<i>[Signature]</i>	3	5-27-80	REVISED NOTE 1				<i>[Signature]</i>
<i>[Signature]</i>	2	10-19-79	ADDED WELD DETAILS		JH	WDD	<i>[Signature]</i>
<i>[Signature]</i>	1	11-30-77	Changed Std. Page No. from Page 4				<i>[Signature]</i>
<i>[Signature]</i>	0	1-20-77	SUPERSEDES 084029 & 085749				<i>[Signature]</i>

GM	<p><b>PIPING - DATA SHEET</b>  <b>BRANCH WELD TEST</b>  <b>GAS STANDARD</b></p> <p>PACIFIC GAS AND ELECTRIC COMPANY                  SAN FRANCISCO, CALIFORNIA</p>	B/M	DRAWING LIST	
SUPV.		SUPERSEDES 084029 & 085749		
DSGN.		SUPERSEDED BY		
DR.		SHEET NO.	SHEETS	
CH.		086406	3	CHANGE
O.K.	DATE	SCALE		
	6-25-75			

**ARC WELDER QUALIFICATION TEST  
FOR PIPING SYSTEMS OPERATING AT HOOP STRESSES OF  
20% OR MORE OF SPECIFIED MINIMUM YIELD STRENGTH**

Passed     Failed    Date Last Tested: \_\_\_\_\_ Date: \_\_\_\_\_

Welder: \_\_\_\_\_ S.S. No.: \_\_\_\_\_

Pipe Dia. \_\_\_\_\_ Pipe Spec. \_\_\_\_\_ Grade \_\_\_\_\_ Wall Thickness \_\_\_\_\_

EXX10     Micro Wire     Butt    Tester: \_\_\_\_\_

(P.G.&E.)

EXX18     Other \_\_\_\_\_     Branch    Weld Position: \_\_\_\_\_

**ELECTRODE MATERIAL:**

Bead	Mfg. & AWS Class	Dia.
1st Bead		
2nd Bead		
Other Beads		

**ELECTRICAL:**

Polarity	Amps	Volts

**WELDING:**

Direction

**TENSILE TESTS:**

Specimen	Width	Thickness	Area-Sq. in.	Load-Lb.	Stress-Psi	Remarks
1						
2						
3						
4						

**FACE BEND OR SIDE BEND:**

Specimen	Location	No. Cracks	Max. Dimension	Location	Remarks
1					
2					

**ROOT BEND OR SIDE BEND:**

1					
2					

**NICK BREAK:**

Specimen No.	Location	Gas Pockets			Slag Inclusion			Fusion	Remarks
		No.	Max. Size	Between	No.	Length	Between		
1									
2									
3									
4									

Contractor: \_\_\_\_\_ Project: \_\_\_\_\_