



PART 1 – TEST DESIGN DATA (TO BE PREPARED BY PROJECT ENGINEER/ESTIMATOR)

Test Description

Line Number or Station Name L-191A Division/District DIABLO Job Number 41918944

Purpose of Test T-343-14: TEST EXISTING 6" & 8" L-191A MAOP to be Established by this Test 283 PSIG

Description of Pipe being Tested (include reference drawings, field stationing, and mile points)
 EXPENSE PORTION OF HYDROSTATIC TEST OF NEW 6" & 8" LINE 191A FROM BRIONES REGIONAL PARK TO

INCLUDING TIE-IN PIECE AND HYDROTEST PIPING, MP 0.002 TO MP 2.97: 3.29
 (REFER TO DWG 41918944-SHEETS 1-12). TO BE TESTED IN CONJUNCTION W/ 31018614 TEST 2.

New Facility (no spike test required) Existing Facility
 Will spike test be performed? Yes No (explain on right) If no spike test for existing facility, explain:

Static Head Calculation

Maximum Elevation 1370 FT For Water 679 (Elev. Diff.) x 0.433 = 295 PSIG
 Minimum Elevation 691 FT For Other Test Medium 0
 Elevation Difference 679 FT Contact the responsible engineer for guidance on completing this field.

Pipe to be Tested

Size		API or ASTM Spec	SMYS (psi)	Long Seam (ERW, DSAW, SMLS etc.)	JF (E)	Footage to be Tested	Actual Footage	Location Class	Most Restrictive Design Factor	% of SMYS		
OD (in.)	WT (in.)									At MAOP	At Min. Test Press.	At Max. Test Press.
8.625"	0.322"	API 5L	35,000	SMLS	1.0	16'-6"	<u>22.90'</u>	1	0.5	10.83	26.02	42.86
6.625"	0.280"	API 5L	35,000	SMLS	1.0	11'-8"	<u>21.74'</u>	3	0.5	9.57	22.98	37.86
<u>8.625"</u>	<u>0.250"</u>		<u>42,000</u>	<u>HFV</u>			<u>15.01'</u>					

101, 111, 112
 04, 115, 116,
 161, 0
 102

All fittings included in the test (except those listed above) are the same wall thickness and grade as the pipe

*Assumed values per PG&E technical specification, Resolving Unknown Pipeline Features 12/5/2012

Pipe specs verified in field Signature of person supervising test GUIDA

Component(s) limiting test pressure/Control Point exceptions

Test Specifications (include a spike test when testing existing facilities)

Test Factor <u>2.4</u>	[1A] Min. Test Pressure at Max. Elev. <u>680</u> PSIG	[1B] Max. Test Pressure at Min. Elev. <u>1120</u> PSIG
Spike Test (complete only for spike test)	[1C] Spike Factor <u>1.20</u>	[1D] Spike Pressure at Max. Elev. Box [1A] X [1C] = <u>816</u> PSIG
	[1E] Spike Pressure at Min. Elev. <u>1111</u> PSIG	[1F] Max. Post-Spike Pressure at Min. Elev. Box [1E] x 0.90 = <u>999</u> PSIG

Test Medium to be Used WATER Minimum Test Duration 1 Hours

- Under 30% SMYS: 1 hour minimum
- 30% SMYS and over: 8 hours minimum
- Pre-installation Test: Refer to A-34, Attachment A
- Spike Test: 30 minutes minimum (included in test)

Signatures

Prepared by (signature) Miles Cronin Print Name and Phone Number MILES CRONIN (925) 914-0095 Date 7-2-14 LAN ID MTCO

Approved by (signature) Don Fink Print Name DONAVON FINK Date 7-2-14 LAN ID D1F7

Test Supervised by (signature) GIANCERVONE 11-11-2014 Time and Date Test Pressure Reached (from Part 2) 1543 11-11-2014 Time and Date Test Ended (from Part 2) 1648 11-11-2014 Actual Duration of Test (from Part 2) HR 5 MIN



PART 1 – TEST DESIGN DATA (TO BE PREPARED BY PROJECT ENGINEER/ESTIMATOR)

Test Description		
Line Number or Station Name	L-191A	Division/District
Purpose of Test	T-343-14: TEST EXISTING 6" & 8" L-191A	Job Number
		DIABLO 41918944
MAOP to be Established by this Test <u>283</u> PSIG		

Description of Pipe being Tested (include reference drawings, field stationing, and mile points)
 TEST EXISTING 6" & 8" LINE 191A FROM BRIONES REGIONAL PARK TO
 [REDACTED] MP 0.002 TO MP 2.97: 3.29
 (REFER TO DWG 41918944-SHEETS 1-12). TO BE TESTED IN CONJUNCTION W/ 31018614 TEST 2.

New Facility (no spike test required) Existing Facility
 Will spike test be performed? Yes No (explain on right)
 If no spike test for existing facility, explain:

Static Head Calculation

Maximum Elevation	<u>1370</u>	FT	For Water <u>670</u> (Elev. Diff.) x 0.433 = <u>291</u> PSIG For Other Test Medium <u>0</u> Contact the responsible engineer for guidance on completing this field.
Minimum Elevation	<u>700</u>	FT	
Elevation Difference	<u>670</u>	FT	

Pipe to be Tested

Size	API or ASTM Spec	SMYS (psi)	Long Seam (ERW, DSAW, SMLS etc.)	JF (E)	Footage to be Tested	Actual Footage	Location Class	Most Restrictive Design Factor	% of SMYS		
									OD (in.)	WT (in.)	At MAOP
8.625"	0.322"	API 5LX	42,000	ERW	1.0	9956'-0" <u>9959.32'</u>	3	0.5	9.02	21.68	35.71
8.625"	0.322"	API 5L	35,000	SMLS	1.0	79'-0" <u>76.92'</u>	1	0.5	10.83	26.02	42.86
6.625"	0.280"	API 5L	35,000	SMLS	1.0	5676'-0" <u>5748.43'</u>	3	0.5	9.57	22.98	37.86
6.625"	0.188"	API 5LX	42,000	ERW	1.0	85'-0" <u>78.10'</u>	3	0.5	11.87	28.53	46.99
1.050"	0.113"	API 5L	35,000	SMLS	1.0	60'-0" <u>MOR</u>	3	0.5	3.76	9.03	14.87
8.625"	0.172"	API 5LX	42000	ERW		<u>1501.12'</u>	3	0.5	17.37	40.59	66.86

All fittings included in the test (except those listed above) are the same wall thickness and grade as the pipe
 *Assumed values per PG&E technical specification, Resolving Unknown Pipeline Features 12/5/2012

Pipe specs verified in field Signature of person supervising test

Component(s) limiting test pressure/Control Point exceptions

Test Specifications (Include a spike test when testing existing facilities)

Test Factor <u>2.4</u>	[1A] Min. Test Pressure at Max. Elev. <u>680</u> PSIG	[1B] Max. Test Pressure at Min. Elev. <u>1120</u> PSIG
Spike Test (complete only for spike test)	[1C] Spike Factor <u>1.20</u>	[1D] Spike Pressure at Max. Elev. Box [1A] x [1C] = <u>816</u> PSIG
	[1E] Spike Pressure at Min. Elev. <u>1407</u> PSIG	[1F] Max. Post-Spike Pressure at Min. Elev. Box [1E] x 0.90 = <u>996</u> PSIG

Test Medium to be Used WATER Minimum Test Duration 1 Hours

- Under 30% SMYS: 1 hour minimum
- 30% SMYS and over: 8 hours minimum
- Pre-installation Test: Refer to A-34, Attachment A
- Spike Test: 30 minutes minimum (included in test)

Signatures

Prepared by (signature)	Print Name and Phone Number	Date	LAN ID
<i>[Signature]</i>	MILES CRONIN (925) 914-0095	<u>7-2-14</u>	MTCO
Approved by (signature)	Print Name	Date	LAN ID
<i>[Signature]</i>	DONAVON FINK	<u>7-2-14</u>	D1F7
Test Supervised by (signature)	Time and Date Test Pressure Reached (from Part 2)	Time and Date Test Ended (from Part 2)	Actual Duration of Test (from Part 2)
<i>[Signature]</i> PG&E GIAN CERVONE GPC 11-11-2014	<u>1543</u> 11-11-2014	<u>1648</u> 11-11-2014	<u>1HR 5 MIN</u>



PART 1 – TEST DESIGN DATA (TO BE PREPARED BY PROJECT ENGINEER/ESTIMATOR)

Test Description												
Line Number or Station Name L-191A						Division/District DIABLO			Job Number 41918944			
Purpose of Test T-343-14: TEST EXISTING 6" & 8" L-191A						MAOP to be Established by this Test <u>283</u> PSIG						
Description of Pipe being Tested (include reference drawings, field stationing, and mile points) TEST EXISTING 6" & 8" LINE 191A FROM REGIONAL PARK TO [REDACTED] MP 0.002 TO MP 2.97 <u>3.29</u> (REFER TO DWG 41918944-SHEETS 1-12). TO BE TESTED IN CONJUNCTION W/ 31018614 TEST 2.												
<input type="checkbox"/> New Facility (no spike test required) <input checked="" type="checkbox"/> Existing Facility Will spike test be performed? <input checked="" type="checkbox"/> Yes <input type="checkbox"/> No (explain on right)						If no spike test for existing facility, explain:						
Static Head Calculation												
Maximum Elevation <u>1370</u> FT						For Water <u>670</u> (Elev. Diff.) x 0.433 = <u>291</u> PSIG						
Minimum Elevation <u>700</u> FT						For Other Test Medium <u>0</u>						
Elevation Difference <u>670</u> FT						Contact the responsible engineer for guidance on completing this field.						
Pipe to be Tested												
Size		API or ASTM Spec	SMYS (psi)	Long Seam (ERW, DSAW, SMLS etc.)	JF (E)	Footage to be Tested	Actual Footage	Location Class	Most Restrictive Design Factor	% of SMYS		
OD (in.)	WT (in.)									At MAOP	At Min. Test Press.	At Max. Test Press.
1.050"	0.113"		28,000*	FBW*	0.6	41'-0"	MOR	3	0.5	4.70	11.28	18.58
1.050"	0.113"		25,000*	FBW*	0.6	18'-0"	MOR	3	0.5	5.26	12.64	20.81
8.625"	0.322"		30,000*	ELBOW	1.0	25 EA	MOR	1	0.5	12.63	30.36	50.00
6.625"	0.280"		30,000*	ELBOW	1.0	5 EA	5 EA.	3	0.5	11.16	26.82	44.17
8.625"	0.322"		30,000*	REDUCER	1.0	1 EA	MOR	1	0.5	12.63	30.36	50.00
All fittings included in the test (except those listed above) are the same wall thickness and grade as the pipe <input checked="" type="checkbox"/>												
*Assumed values per PG&E technical specification, Resolving Unknown Pipeline Features 12/5/2012												
Pipe specs verified in field <input type="checkbox"/> Signature of person supervising test												
Component(s) limiting test pressure/Control Point exceptions												
Test Specifications (Include a spike test when testing existing facilities)												
Test Factor <u>2.4</u>	[1A]	Min. Test Pressure at Max. Elev. <u>680</u> PSIG				[1B]	Max. Test Pressure at Min. Elev. <u>1120</u> PSIG					
Spike Test (complete only for spike test)	[1C]	Spike Factor <u>1.20</u>				[1D]	Spike Pressure at Max. Elev. Box [1A] X [1C] = <u>816</u> PSIG					
	[1E]	Spike Pressure at Min. Elev. <u>447</u> PSIG <u>2c IIII</u>				[1F]	Max. Post-Spike Pressure at Min. Elev. Box [1E] X 0.90 = <u>996</u> PSIG					
Test Medium to be Used <u>WATER</u>			Minimum Test Duration <u>1</u> Hours			<ul style="list-style-type: none"> Under 30% SMYS: 1 hour minimum 30% SMYS and over: 8 hours minimum Pre-installation Test: Refer to A-34, Attachment A Spike Test: 30 minutes minimum (included in test) 						
Signatures												
Prepared by (signature) <i>[Signature]</i>			Print Name and Phone Number MILES CRONIN (925) 914-0095				Date <u>7-2-14</u>		LAN ID MTCO			
Approved by (signature) <i>[Signature]</i>			Print Name DONAVON FINK				Date <u>7-2-14</u>		LAN ID D1F7			
Test Supervised by (signature) <i>[Signature]</i>			Time and Date Test Pressure Reached (from Part 2) <u>1543 11-11-2014</u>		Time and Date Test Ended (from Part 2) <u>1648 11-11-2014</u>		Actual Duration of Test (from Part 2) <u>1HR 5 MIN</u>					

14
15
8
11
12



PART 2 – TEST DATA (TO BE PREPARED BY PERSON SUPERVISING TEST AT TIME OF TEST)

Test Elevation			
Elevation at Test Point <u>726</u> FT	Max. Elevation in Test Section <u>1370</u> FT	Min. Elevation in Test Section <u>691</u> FT	
[2A]	Static Head b/t Test Point and Max. Elev. <u>279</u> PSIG	[2B]	Static Head b/t Test Point and Min. Elev. <u>16</u> PSIG
No Spike Test: Calculations and Test Results (complete for strength test without a spike test)			
Min. Required Test Pressure at Test Point Box [1A] + Box [2A] = _____ PSIG		Max. Allowable Test Pressure at Test Point Box [1B] – Box [2B] = _____ PSIG	
[2C]	Min. Test Pressure Indicated _____ PSIG	[2D]	Max. Test Pressure Indicated _____ PSIG
Calculated Min. Test Pressure at Max. Elev. Box [2C] – Box [2A] = _____ PSIG		Calculated Max. Test Pressure at Min. Elev. Box [2D] + Box [2B] = _____ PSIG	
Spike Test: Calculations and Test Results (complete for strength test with a spike test)			
Spike Pressure at Test Point Box [1E] – Box [2B] = <u>1095</u> PSIG		Min. Required Test Pressure at Test Point Box [1A] + Box [2A] = <u>959</u> PSIG	
[2E]	Spike Pressure Indicated <u>1095</u> PSIG	[2F]	Min. Test Pressure Indicated <u>969</u> PSIG
Calculated Spike Pressure at Min. Elev. Box [2E] + Box [2B] = <u>1111</u> PSIG		Calculated Min. Test Pressure at Max. Elev. Box [2F] – Box [2A] = <u>690</u> PSIG	
		Max. Post-Spike Pressure at Test Point Box [1F] – Box [2B] = <u>983</u> PSIG	
[2G]		[2H]	Max. Post-Spike Test Pressure Indicated <u>970</u> PSIG
		Pressure Range After Spike Test <u>24</u> PSIG	
		Calculated Max. Post-Spike Pressure at Min. Elev. Box [2G] + Box [2B] = <u>986</u> PSIG	
Test Acceptance			
Were Leaks Observed? <input type="checkbox"/> Yes <input checked="" type="checkbox"/> No		If yes, explain:	
Acceptable Strength Test? <input checked="" type="checkbox"/> Yes <input type="checkbox"/> No		If no, explain:	
Report strength test failures to Regulatory Compliance			
Test Medium Used <u>WATER</u>	Time and Date Test Pressure Reached <u>1543 11-11-2014</u>	Time and Date Test Ended <u>1648 11-11-2014</u>	Actual Duration of Test <u>1 HR 5 MIN</u>
Test Instruments			
Make, Range, and Serial No. of Pressure Recording Device <u>TECH-CAL, 0-2000#, 04346</u>			Date Last Calibrated <u>10/16/2014</u>
Make, Range and Serial No. of Dead Weight Tester A dead weight tester and/or an electronic pressure recorder is required for tests of any pipe segment equal to or greater than 90% of SMYS. <u>AMETEK, 25-3000#, HLG413</u>			Date Last Calibrated <u>3/18/2014</u>
Signatures			
Test Supervised by (signature) <u>[Signature]</u>	Print Name <u>GIAN CERVONE</u>	Date <u>11-11-2014</u>	LAN ID <u>GPCC</u>
Testing Contractor (if third party) <u>ARB</u>			
Approved by (signature) <u>[Signature]</u>	Print Name <u>AZRA TARIN</u>	Date <u>11-22-14</u>	LAN ID <u>AXTB</u>

Attachments

- Test chart
- Schematic piping sketch
- Test log with pressure noted every 15 minutes

Distribution

- Gas Job Closeout Desk, 6121 Bollinger Canyon Road, Building Z1, San Ramon, CA 94583



PART 1 – TEST DESIGN DATA (TO BE PREPARED BY PROJECT ENGINEER/ESTIMATOR)

Test Description												
Line Number or Station Name L-191A						Division/District DIABLO			Job Number 31018614			
Purpose of Test T-343-14: TEST EXISTING 6" & 8" L-191A						MAOP to be Established by this Test <u>283</u> PSIG						
Description of Pipe being Tested (include reference drawings, field stationing, and mile points) CAPITAL PORTION OF HYDROSTATIC TEST OF EXISTING 6" & 8" LINE 191A TO MAKE LINE PIGGABLE, (REFER TO DWG 41918944-SHEETS 4-5 & 10 OF 12). TO BE TESTED IN CONJUNCTION W/ 41918944 TEST 2. - LINE VALVE ASSEMBLY AT LOCATION O, MP 3.29												
<input checked="" type="checkbox"/> New Facility (no spike test required) <input type="checkbox"/> Existing Facility Will spike test be performed? <input checked="" type="checkbox"/> Yes <input type="checkbox"/> No (explain on right)						If no spike test for existing facility, explain:						
Static Head Calculation												
Maximum Elevation <u>1370</u> FT						For Water <u>679</u> (Elev. Diff.) x 0.433 = <u>295</u> PSIG						
Minimum Elevation <u>691</u> FT						For Other Test Medium <u>0</u>						
Elevation Difference <u>679</u> FT						Contact the responsible engineer for guidance on completing this field.						
Pipe to be Tested												
Size		API or ASTM Spec	SMYS (psi)	Long Seam (ERW, DSAW, SMLS etc.)	JF (E)	Footage to be Tested	Actual Footage	Location Class	Most Restrictive Design Factor	% of SMYS		
OD (in.)	WT (in.)									At MAOP	At Min. Test Press.	At Max. Test Press.
8.625"	0.322"	API 5L	35,000	SMLS	1.0	740'	17.98'	1	0.5	10.83	26.02	42.86
6.625"	0.280"	API 5L	35,000	SMLS	1.0	346'	141.79'	3	0.5	9.57	22.98	37.86
8.625"	0.250"		42,000	HFW			2.97'	3	0.5	10.83	26.02	42.86
3.500"	0.216"		35,000	SMLS			2.88'	3	0.5	6.55	15.74	25.92
2.375"	0.154"		35,000	SMLS			9.48'	3	0.5	6.23	14.98	24.68
1.050"	0.154"		35,000	SMLS			13.80'	3	0.5	2.76	6.62	10.91
All fittings included in the test (except those listed above) are the same wall thickness and grade as the pipe <input checked="" type="checkbox"/>												
Pipe specs verified in field <input checked="" type="checkbox"/> Signature of person supervising test <u>GUIDA</u>												
Component(s) limiting test pressure/Control Point exceptions												
Test Specifications (include a spike test when testing existing facilities)												
Test Factor <u>2.4</u>	[1A]	Min. Test Pressure at Max. Elev. <u>680</u> PSIG				[1B]	Max. Test Pressure at Min. Elev. <u>1120</u> PSIG					
Spike Test (complete only for spike test)	[1C]	Spike Factor <u>1.20</u>				[1D]	Spike Pressure at Max. Elev. Box [1A] X [1C] = <u>816</u> PSIG					
	[1E]	Spike Pressure at Min. Elev. <u>1111</u> PSIG				[1F]	Max. Post-Spike Pressure at Min. Elev. Box [1E] X 0.90 = <u>999</u> PSIG					
Test Medium to be Used <u>WATER</u>			Minimum Test Duration <u>1</u> Hours			<ul style="list-style-type: none"> Under 30% SMYS: 1 hour minimum 30% SMYS and over: 8 hours minimum Pre-installation Test: Refer to A-34, Attachment A Spike Test: 30 minutes minimum (included in test) 						
Signatures												
Prepared by (signature) <u>[Signature]</u>				Print Name and Phone Number MILES CRONIN (925) 914-0095				Date <u>7-2-14</u>		LAN ID MTCO		
Approved by (signature) <u>[Signature]</u>				Print Name DONAVON FINK				Date <u>7-2-14</u>		LAN ID D1F7		
Test Supervised by (signature) <u>[Signature]</u> <u>11-11-2014</u>				Time and Date Test Pressure Reached (from Part 2) <u>1543 11-11-2014</u>			Time and Date Test Ended (from Part 2) <u>11-11-2014</u>		Actual Duration of Test (from Part 2) <u>1 HR MIN</u>			

01,11,112,
 21,126,201
 24,115,116,0
 102
 25,122,124
 06,C,162
 07,117,
 05,169,167,
 168



PART 2 – TEST DATA (TO BE PREPARED BY PERSON SUPERVISING TEST AT TIME OF TEST)


Test Elevation			
Elevation at Test Point <u>726</u> FT		Max. Elevation in Test Section <u>1370</u> FT	Min. Elevation in Test Section <u>691</u> FT
[2A]	Static Head b/t Test Point and Max. Elev. <u>279</u> PSIG		[2B] Static Head b/t Test Point and Min. Elev. <u>16</u> PSIG
No Spike Test: Calculations and Test Results (complete for strength test without a spike test)			
Min. Required Test Pressure at Test Point Box [1A] + Box [2A] = <u>959</u> PSIG		Max. Allowable Test Pressure at Test Point Box [1B] – Box [2B] = _____ PSIG	Pressure Range During Test _____ PSIG
[2C]	Min. Test Pressure Indicated _____ PSIG	[2D]	Max. Test Pressure Indicated _____ PSIG
Calculated Min. Test Pressure at Max. Elev. Box [2C] – Box [2A] = _____ PSIG		Calculated Max. Test Pressure at Min. Elev. Box [2D] + Box [2B] = _____ PSIG	
Spike Test: Calculations and Test Results (complete for strength test with a spike test)			
Spike Pressure at Test Point Box [1E] – Box [2B] = <u>1095</u> PSIG		Min. Required Test Pressure at Test Point Box [1A] + Box [2A] = <u>959</u> PSIG	Max. Post-Spike Pressure at Test Point Box [1F] – Box [2B] = <u>983</u> PSIG
[2E]	Spike Pressure Indicated <u>1095</u> PSIG	[2F]	Min. Test Pressure Indicated <u>969</u> PSIG
Calculated Spike Pressure at Min. Elev. Box [2E] + Box [2B] = <u>1111</u> PSIG		Calculated Min. Test Pressure at Max. Elev. Box [2F] – Box [2A] = <u>690</u> PSIG	Calculated Max. Post-Spike Pressure at Min. Elev. Box [2G] + Box [2B] = <u>986</u> PSIG
Test Acceptance			
Were Leaks Observed? <input type="checkbox"/> Yes <input checked="" type="checkbox"/> No		If yes, explain:	
Acceptable Strength Test? <input checked="" type="checkbox"/> Yes <input type="checkbox"/> No Report strength test failures to Regulatory Compliance		If no, explain:	
Test Medium Used <u>WATER</u>	Time and Date Test Pressure Reached <u>1543 11-11-2014</u>	Time and Date Test Ended <u>1648 11-11-2014</u>	Actual Duration of Test <u>1 HR 5 MIN</u>
Test Instruments			
Make, Range, and Serial No. of Pressure Recording Device <u>TECH-CAL, 0-2000, 04346</u>			Date Last Calibrated <u>10/16/2014</u>
Make, Range and Serial No. of Dead Weight Tester A dead weight tester and/or an electronic pressure recorder is required for tests of any pipe segment equal to or greater than 90% of SMYS. <u>AMETEK, 25-3000#, HL6413</u>			Date Last Calibrated <u>3/18/2014</u>
Signatures			
Test Supervised by (signature) <u>[Signature]</u>		Print Name <u>GIAN CERVONE</u>	Date <u>11-11-2014</u>
Testing Contractor (if third party) <u>ARB</u>			
Approved by (signature) <u>[Signature]</u>		Print Name <u>AZUH TARIN</u>	Date <u>11-22-14</u>
LAN ID <u>GPCC</u>		LAN ID <u>AXTB</u>	

Attachments

- Test chart
- Schematic piping sketch
- Test log with pressure noted every 15 minutes

Distribution

- Gas Job Closeout Desk, 6121 Bollinger Canyon Road, Building Z1, San Ramon, CA 94583

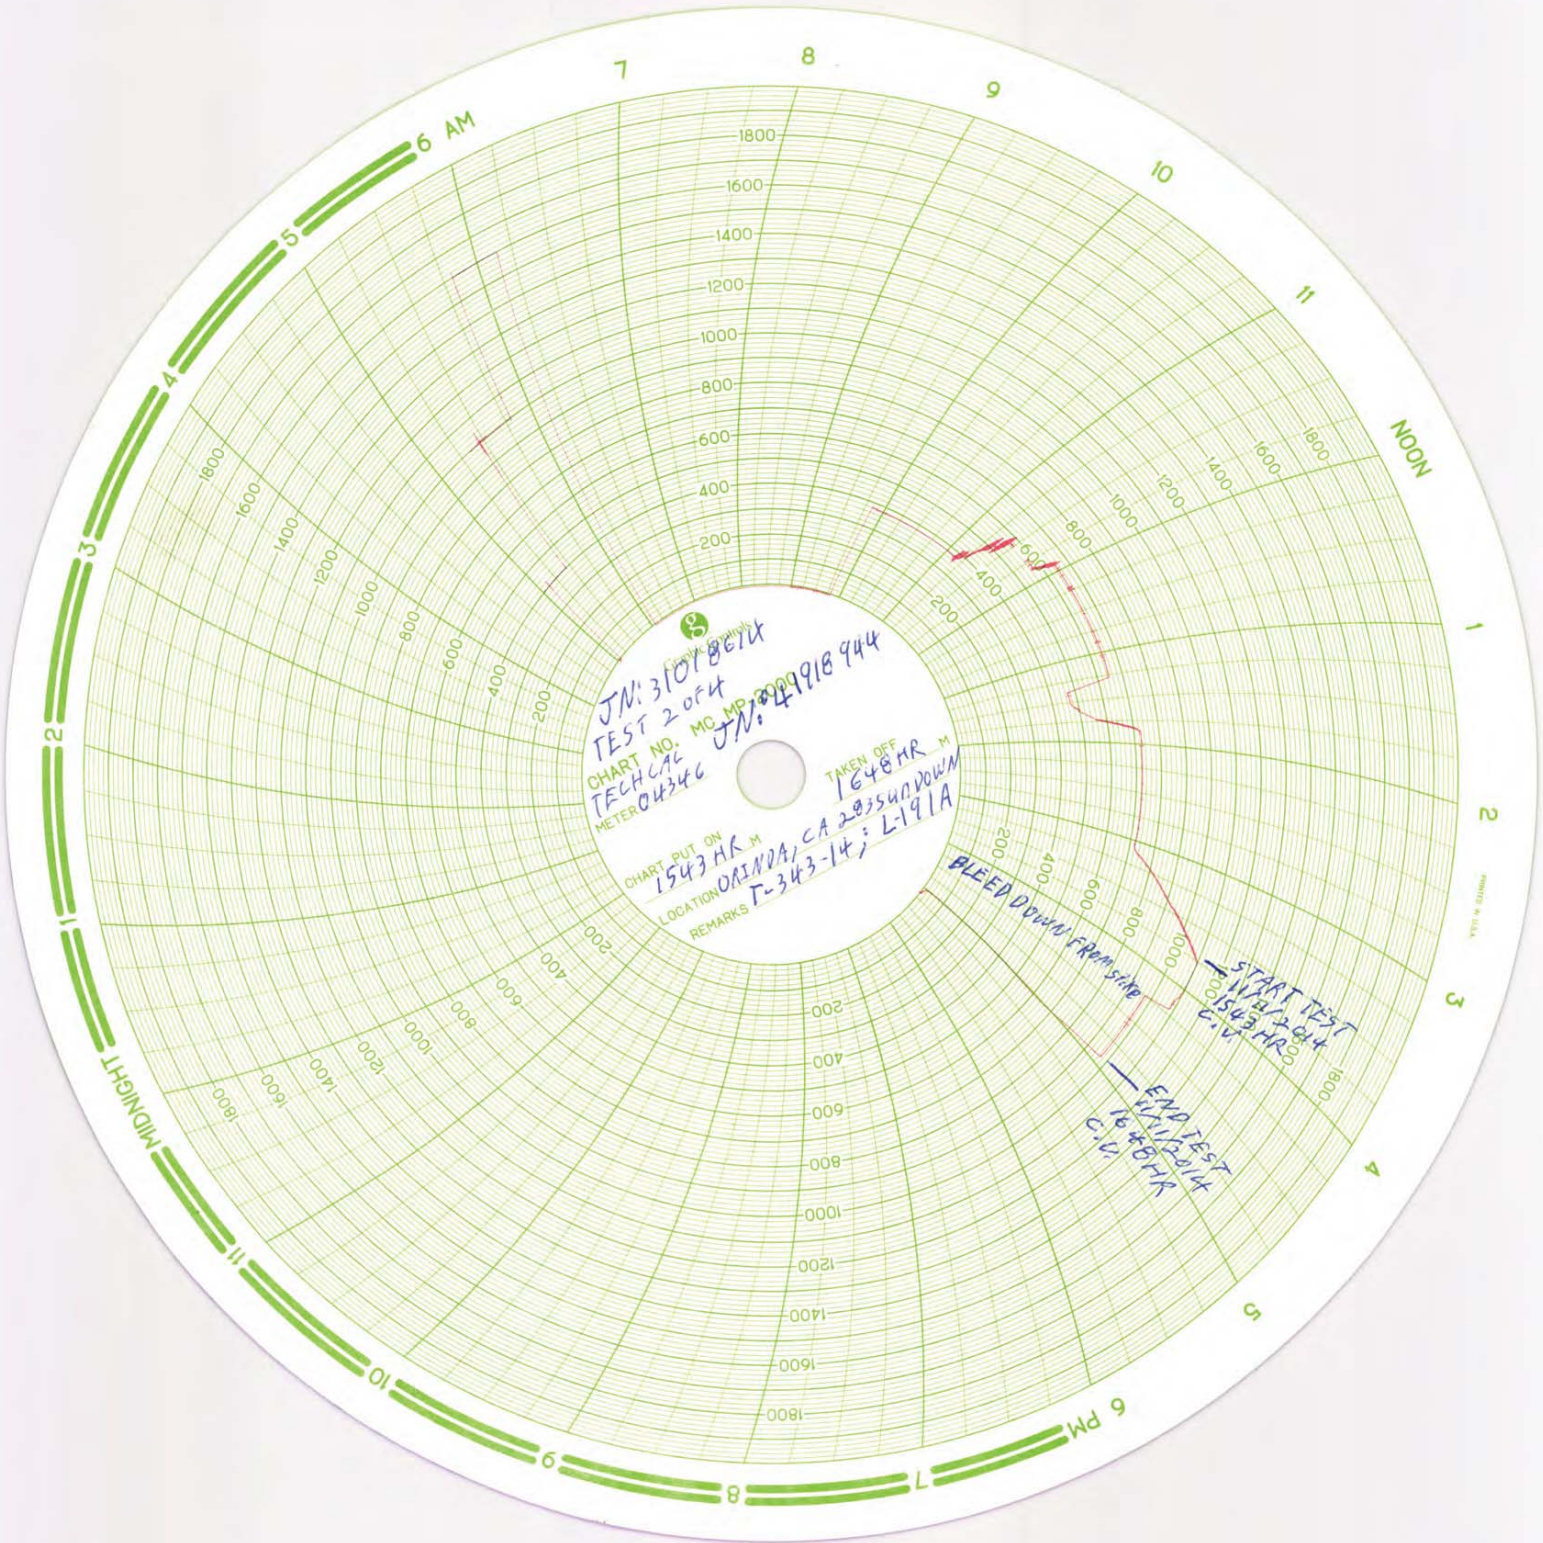

JM: 31018614
 TEST 2 OF 4
 CHART NO. MC MP 2000
 TECH CAE JM: 41918944
 METER 04346
 CHART PUT ON 1543 HR M
 REMARKS T-343-14; L-191A
 TAKEN OFF 1648 HR M

BLEED DOWN FROM STATE
 START TEST
 1543 HR M
 2035 HRS
 C.V.
 END TEST
 1648 HR M
 C.V.

PT-11 W. 822000

STRENGTH TEST INFORMATION RE-1

1 JOB # 31018614 TEST 2 of 4 41918944
 5 RECORDING GA. MFG. TECHCAL SER.# 04346
 6 RANGE 0-2000 PSF LAST CALIBRATED HL6413
 7 DEAD WGT MFG. AMETEK SER.# 31812014
 8 RANGE 25-2000 PSF LAST CALIBRATED _____
 9 TEST FLUID WATER PIPE SPEC. API 5L 35000 SMLS LENGTH 12.98'
 10 SIZE 8.625" W.T. 0.322" PIPE SPEC. API 5L 35000 SMLS DATE 11-11-2014
 11 SIZE 14.75" W.T. 0.625" PIPE SPEC. API 5L 35000 SMLS DATE 11-22-14
 12 SUPERVISED W. W. GIAN CERVONE SPCS DATE _____
 13 APPROVED [Signature] DATE _____


NO.	SIZE	W.T.	PIPE SPEC.	LENGTH	DATE	LENGTH	DATE
14.	SIZE <u>8.625"</u>	W.T. <u>0.250"</u>	PIPE SPEC. <u>API 5L 42000 HFW</u>	LENGTH <u>2.97'</u>			
15.	SIZE <u>2.500"</u>	W.T. <u>0.216"</u>	PIPE SPEC. <u>API 5L 35000 SMLS</u>	LENGTH <u>2.88'</u>			
16.	SIZE <u>2.375"</u>	W.T. <u>0.194"</u>	PIPE SPEC. <u>API 5L 35000 SMLS</u>	LENGTH <u>9.48'</u>			
17.	SIZE <u>1.050"</u>	W.T. <u>0.154"</u>	PIPE SPEC. <u>API 5L 35000 SMLS</u>	LENGTH <u>13.80'</u>			
18.	SIZE <u>8.625"</u>	W.T. <u>0.222"</u>	PIPE SPEC. <u>API 5L 42000 HFW</u>	LENGTH <u>21.74'</u>			
19.	SIZE <u>8.625"</u>	W.T. <u>0.250"</u>	PIPE SPEC. <u>API 5L 35000 SMLS</u>	LENGTH <u>15.01'</u>			
20.	SIZE <u>8.625"</u>	W.T. <u>0.222"</u>	PIPE SPEC. <u>API 5L 42000 HFW</u>	LENGTH <u>99.932'</u>			
21.	SIZE <u>8.625"</u>	W.T. <u>0.280"</u>	PIPE SPEC. <u>API 5L 42000 ERW</u>	LENGTH <u>52.4843'</u>			
22.	SIZE <u>8.625"</u>	W.T. <u>0.322"</u>	PIPE SPEC. <u>API 5L 35000 SMLS</u>	LENGTH <u>28.10'</u>			


1 2 3 4 5 6 7 8 9 10

E
D
C
B
A

E
D
C
B
A

 

COPY

SAFETY
SAFETY PLEDGE
I ALWAYS WEAR MY SAFETY PLEDGE.
I LOOK FOR AND ACT TO
RESOLVE UNSAFE SITUATIONS.
I HELP AND ENCOURAGE
OTHERS TO ACT SAFELY.

GTS
875 LANTANA AVE
PACIFIC GARDEN, CA 95051-1700
www.gts.com
Phone No 510-958-1100



NOT BEING CONFIDENTIAL, PROPRIETARY INFORMATION THIS DOCUMENT CONTAINS CONFIDENTIAL, PROPRIETARY INFORMATION THAT IS THE SOLE PROPERTY OF PACIFIC GAS AND ELECTRIC COMPANY AND IS INTENDED FOR USE ONLY BY AUTHORIZED PACIFIC GAS AND ELECTRIC COMPANY EMPLOYEES & AGENTS. COPYRIGHT PACIFIC GAS AND ELECTRIC COMPANY.



NO.	DATE	DESCRIPTION	BY	CHKD BY
1	11-17-11	RECORD SET FOR 20, 21, 22 & LOCATION 040	4718284	4718284
2	11-17-11	ISSUED FOR CONSTRUCTION	4718284	4718284
3	04-18	REVISION	4718284	4718284

HYDROTEST T-343-14
L-191A
MP 0.000 - 4.84
ORINDA, CALIFORNIA
PACIFIC GAS AND ELECTRIC COMPANY
SAN FRANCISCO, CALIFORNIA

SHEET NO. 42 OF 112 SHEETS
41918944 1

1 2 3 4 5 6 7 8 9 10

1 2 3 4 5 6 7 8 9 10

E

E

D

D

C


C

B

B

A

A

 

SAFETY PLEDGE
I ALWAYS WEAR MY SAFETY GEAR.
I STOP FOR AND NOT TO RESUME WORK UNTIL I AM PROPERLY TRAINED.
I HELP AND ENCOURAGE OTHERS TO ACT SAFELY.



THIS DRAWING IS CONFIDENTIAL, PROPRIETARY INFORMATION. THIS DOCUMENT CONTAINS CONFIDENTIAL, PROPRIETARY INFORMATION THAT IS THE SOLE PROPERTY OF PACIFIC GAS AND ELECTRIC COMPANY AND IS INTENDED FOR USE ONLY BY AUTHORIZED PACIFIC GAS AND ELECTRIC COMPANY EMPLOYEES. IF YOU ARE NOT AN EMPLOYEE OF PACIFIC GAS AND ELECTRIC COMPANY,



NO.	DATE	DESCRIPTION	BY	CHKD BY
1	11-30-14	REVISED DETAILS TO 2A, 2B & LOCATION LOG	419-8944 (MAM/MS)	419-8944 (MAM/MS)
2	11-24-14	COLLECTION CONNECTION	419-8944 (MAM/MS)	419-8944 (MAM/MS)
3	04-08-14	REVISION	419-8944 (MAM/MS)	419-8944 (MAM/MS)

HYDROTEST 1-343-14
L-191A
MP 0.002 - 4.84
ORINDA, CALIFORNIA
PACIFIC GAS AND ELECTRIC COMPANY
SAN FRANCISCO, CALIFORNIA


1 OF 848 SHEET 12
SHEET LIST
SHEET NO. 39 OF 72 SHEETS
41918944 1

1 2 3 4 5 6 7 8 9 10

1 2 3 4 5 6 7 8 9 10

E
D
C
B
A

E
D
C
B
A

 

ALL DRAWING INFORMATION IS THE SOLE PROPERTY OF PACIFIC GAS AND ELECTRIC COMPANY AND IS INTENDED FOR USE ONLY BY AUTHORIZED PACIFIC GAS AND ELECTRIC COMPANY EMPLOYEES & AGENTS. COPYRIGHT PACIFIC GAS AND ELECTRIC COMPANY.



NO.	DATE	DESCRIPTION	BY	CHKD
1	08/03/14	ISSUED FOR CONSTRUCTION	W. J. B.	W. J. B.
2	08/03/14	ISSUED FOR CONSTRUCTION	W. J. B.	W. J. B.
HYDROLIST T-343-14
L-191A
MP 0.002 - 4.84
ORINDA, CALIFORNIA
PACIFIC GAS AND ELECTRIC COMPANY
SAN FRANCISCO, CALIFORNIA

SAFETY
SAFETY PLEDGE
I HAVE PUT SAFETY FIRST
I LOOK FOR AND ACT TO
RESOLVE unsafe situations.
I HELP AND ENCOURAGE
OTHERS TO ACT SAFELY.

GTS
875 LAMAR ST. 4TH
FLOOR SAN FRANCISCO, CA 94108
WWW.GTS.US
PHONE NO. 415.774.1210

REGISTERED PROFESSIONAL ENGINEER
W. J. B.
No. 453704
Exp. 08-30-2015
STATE OF CALIFORNIA

1 2 3 4 5 6 7 8 9 10



4595 Chabot Suite 115
Pleasanton, CA 94588
(925) 398-0805
EMAIL: ag@guidasurveying.com

PROJECT DESCRIPTION: T-343 CONTRACTOR: PGE PG&E JOB #: 41918944/31018614 SKETCH PREPARED DATE: 11-9-2014 SHEET: 1 OF 14

JOB NAME: HYDROTEST T-343-14, L-191A, MP 0.002 - 4.84 GSI J.N.: 0214-00199.0001 CREW NAME: JOHN LANFRANKI / JOE VARGAS





4195 Chabot Suite 115
Pleasanton, CA 94588
(925) 398-0805
EMAIL: info@guidasurveying.com

PROJECT DESCRIPTION: T-343 CONTRACTOR: PGE PG&E JOB #: 41918944/31018614 SKETCH PREPARED DATE: 11-9-2014 SHEET: 2 OF 14

JOB NAME: HYDROTEST T-343-14, L-191A, MP 0.002 - 4.84 GSI J.N.: 0214-00199.0001 CREW NAME: JOHN LANFRANKI / JOE VARGAS






4695 Chabot Suite 115
Pleasanton, CA 94588
(925) 398-0905
EMAIL: slg@guidasurveying.com

PROJECT DESCRIPTION: T-343 CONTRACTOR: PGE PG&E JOB #: 41918944/31018614 SKETCH PREPARED DATE: 11-9-2014 SHEET: 3 OF 14

JOB NAME: HYDROTEST T-343-14, L-191A, MP 0.002 - 4.84 GSI J.N.: 0214-00199.0001 CREW NAME: JOHN LANFRANKI / JOE VARGAS

 


1
2



4695 Chabot Suite 115
Pleasanton, CA 94588
(925) 798-0800
EMAIL: ag@guidasurveying.com

PROJECT DESCRIPTION: T-343 CONTRACTOR: PGE PG&E JOB #: 41918944/31018614 SKETCH PREPARED DATE: 11-9-2014 SHEET: 4 OF 14

JOB NAME: HYDROTEST T-343-14, L-191A, MP 0.002 - 4.84 GSI J.N.: 0214-00199.0001 CREW NAME: JOHN LANFRANKI / JOE VARGAS

 

11



4095 Chabot Suite 115
Pleasanton, CA 94588
(925) 798-0805
EMAIL: aj@guidasurveying.com

PROJECT DESCRIPTION: T-343 CONTRACTOR: PGE PG&E JOB #: 41918944/31018614 SKETCH PREPARED DATE: 11-9-2014 SHEET: 5 OF 14

JOB NAME: HYDROTEST T-343-14, L-191A, MP 0.002 - 4.84 GSI J.N.: 0214-00199.0001 CREW NAME: JOHN LANFRANKI / JOE VARGAS






4695 Chabot Suite 115
Pleasanton, CA 94558
(925) 398-6805
EMAIL: at@guidasurveying.com

PROJECT DESCRIPTION: T-343 CONTRACTOR: PGE PG&E JOB #: 41918944/31018614 SKETCH PREPARED DATE: 11-9-2014 SHEET: 6 OF 14

JOB NAME: HYDROTEST T-343-14, L-191A, MP 0.002 - 4.84 GSI J.N.: 0214-00199.0001 CREW NAME: JOHN LANFRANKI / JOE VARGAS

 




4055 Chabot Suite 115
Pleasanton, CA 94588
(925) 358-0805
EMAIL: sl@guidasurveying.com

PROJECT DESCRIPTION: T-343 CONTRACTOR: PGE PG&E JOB #: 41918944/31018614 SKETCH PREPARED DATE: 11-9-2014 SHEET: 7 OF 14


JOB NAME: HYDROTEST T-343-14, L-191A, MP 0.002 - 4.84 GSI J.N.: 0214-00199.0001 CREW NAME: JOHN LANFRANKI / JOE VARGAS

 



4095 Chabot Suite 115
Pleasanton, CA 94588
(925) 798-0805
E-Mail: al@guidasurveying.com

PROJECT DESCRIPTION: T-343 CONTRACTOR: PG&E PG&E JOB #: 31018614 SKETCH PREPARED DATE: 11/09/2014 SHEET: 8 OF 14
JOB NAME: LOCATION F, DETAIL 12 GSI J.N.: 0214-00199.0001 CREW NAME: MAJEEED HASHIMI

 




4535 Chabot Suite 115
Pleasanton, CA 94588
(925) 399-0805
EMAIL: al@guidasurveying.com

PROJECT DESCRIPTION: T-343 CONTRACTOR: PG&E PG&E JOB #: 41918944 SKETCH PREPARED DATE: 11/09/2014 SHEET: 9 OF 14

JOB NAME: LOCATION F, DETAIL B GSI J.N.: 0214-00199.0001 CREW NAME: MAJEED HASHIMI

 




4895 Chabot Suite 115
Pleasanton, CA 94588
(925) 398-0805
EMAIL: ag@guidasurveying.com

PROJECT DESCRIPTION: T-343 CONTRACTOR: PG&E PG&E JOB #: 31018614 SKETCH PREPARED DATE: 11/09/2014 SHEET: 10 OF 14


JOB NAME: LOCATION G_DETAIL 13 GSI J.N.: 0214-00199.0001 CREW NAME: MAJEED HASHIMI

 



4695 Chabot Suite 115
Pleasanton, CA 94588
(925) 218-0805
EMAIL: ag@guidasurveying.com

PROJECT DESCRIPTION: T-343 CONTRACTOR: PG&E PG&E JOB #: 31018614 SKETCH PREPARED DATE: 11/09/2014 SHEET: 11 OF 14
JOB NAME: LOCATION O, TEST HEAD GSI J.N.: 0214-00199.0001 CREW NAME: MAJEED HASHIMI

 




4695 Chabot Suite 115
Pleasanton, CA 94588
(925) 398-0805
EMAIL: info@guidasurveying.com

PROJECT DESCRIPTION: T-343 CONTRACTOR: PG&E PG&E JOB #: 41918944 SKETCH PREPARED DATE: 11/09/2014 SHEET: 12 OF 14


JOB NAME: LOCATION O, TEST HEAD GSI J.N.: 0214-00199.0001 CREW NAME: MAJEED HASHIMI

 



4695 Chabot Suite 115
Pleasanton, CA 94588
(925) 398-0205
EMAIL: ah@guidasurveying.com

PROJECT DESCRIPTION: T-343 CONTRACTOR: PG&E PG&E JOB #: 41918944 SKETCH PREPARED DATE: 11/09/2014 SHEET: 13 OF 14
JOB NAME: TEST BULLET GSI J.N.: 0214-00199.0001 CREW NAME: MAJEED HASHIMI

 




4695 Chabot Suite 115
Pleasanton, CA 94588
(925) 398-0605
EMAIL: stg@guidasurveying.com

PROJECT DESC.: T-343-14 HYDROTEST LOCATION: T-343, LOC. O, DET. 20

PG&E JOB #: 41918944/31018614 GSI JOB #: 0214-00199.0001

CONTRACTOR: PGE DATE: 11-9-14

CREW NAME: JOE VARGAS / DON THOMPSON SHEET: 14 OF 14

 

A:B		HYDROSTATIC TEST LOG SHEET					Date			
							11/11/2014			
Owner Company:		PG&E			Job Number:		41918944			
Construction Co:		ARB INC			Job Number:		31018614 TEST 2 OF 4			
Testing Co:		ARB INC			Job Number:					
Test Section	Name:		COREY VINCENT 65075 ; 0628-046C T-343-14 , L-191A							
			Station (0+00)			Elevation (Feet)				
	Test Location:		LOC. O 172+37			726				
	Begin:		LOC. A 0+00			1316				
	End:		172+37			726				
	High Elevation:		4+65			1370				
Low Elevation:		151+09			691					
Pipe Data	Section	Length (ft.)	O.D. (in.)	W.T. (in.)	Restrained (ft.)	Unrestrained (ft.)	Grade	Seam/Joint Type		
	1.	17.98	8.625	0.322	17.98		API-5L 35000	SMLS		
	2.	141.79	6.625	0.280	141.79		API-5L 35000	SMLS		
	3.	2.97	8.625	0.250	2.97		API-5L 42000	HFV		
	4.	2.88	3.500	0.216	2.88		API-5L 35000	SMLS		
	5.	9.48	2.375	0.154	9.48		API-5L 35000	SMLS		
	6.	13.80	1.050	0.154	13.80		API-5L 35000	SMLS		
	7.	22.90	8.625	0.322	22.90		API-5L 35000	SMLS		
	8.	21.74	8.625	0.280	21.74		API-5L 35000	SMLS		
	9.	15.01	8.625	0.250	15.01		API-5L 42000	HFV		
	10.	9959.32	8.625	0.322	99.59		API-5LX 42000	ERW		
	11.	76.92	8.625	0.322	76.92		API-5L 35000	SMLS		
	12.	5748.43	6.625	0.280	5748.43		API-5L 35000	SMLS		
	13.	78.10	6.625	0.188	78.10		API-5LX 42000	ERW		
	14.	MOR	1.050	0.113	MOR		API-5L 35000	SMLS		
	15.	1501.12	8.625	0.172	1501.12		API-5L 42000	ERW		
	16.	MOR	1.050	0.133	MOR		28000	FBW		
	17.	MOR	1.050	0.133	MOR		25000	FBW		
	18.	MOR	8.625	0.322	MOR		30000	ELBOW		
	19.	SEA	6.625	0.280	MOR		30000	ELBOW		
	20.	MOR	8.625	0.322	MOR		30000	REDUCER		
	21.									
	22.									
	23.									
	24.									
	25.									
	26.									
	27.									
28.										
Test Period	Date		Time		Test Medium	Water:	<input checked="" type="checkbox"/>			
	Begin:	11/11/2014	1543	Nitrogen:		<input type="checkbox"/>				
	End:	11/11/2014	1648	Other:		<input type="checkbox"/>				
Test Instrumentation	Description		Calibration Checked		Serial Number		Date Calibrated/Certified		Installation Correct?	
	Dead Weight Pressure Tester:		<input checked="" type="checkbox"/>	Yes	HL6413		3/18/2014		<input checked="" type="checkbox"/>	Yes
	Pressure Recorder:		<input checked="" type="checkbox"/>	Yes	04346		10/16/2014		<input checked="" type="checkbox"/>	Yes
	Ambient Temperature Recorder:		<input checked="" type="checkbox"/>	Yes	02099		8/28/2014		<input checked="" type="checkbox"/>	Yes
	Restrained Pipe Temperature Recorder:		<input checked="" type="checkbox"/>	Yes	02100		10/1/2014		<input checked="" type="checkbox"/>	Yes
Unrestrained Pipe Temperature Recorder:		<input checked="" type="checkbox"/>	Yes	02101		5/23/2014		<input checked="" type="checkbox"/>	Yes	



DEAD WEIGHT TEST LOG


ARB Job Number: 0628-046C

Log No.	Time 24HR	Test Pressure (psig)	Temperature (°F)			Volume			Comments:	Stroke Count
			Ambient	Pipe		<input type="checkbox"/> Ounces Bleed	<input checked="" type="checkbox"/> Gallons Inject			
				Restrained	Unrestrained					
1.	1352	720	60	61	67			75% , 1 HOUR HOLD	0	
2.	1500	716	60	61	67					
3.	1543	1095	60	61	67			SPIKE / ON TEST	944	
4.	1548	1094	60	61	67					
5.	1553	1093	59	61	67					
6.	1558	1093	59	61	67					
7.	1601	1093	59	61	67	START				
8.	1605	1083	59	61	67	STOP				
9.	1609	1083	59	61	67	1.75				
10.	1615	970	58	61	68					
11.	1620	970	58	62	68					
12.	1625	970	58	62	68					
13.	1630	970	58	62	68					
14.	1635	970	58	62	68					
15.	1640	970	58	62	68					
16.	1645	969	58	62	67					
17.	1648	969	58	62	67					
18.										
19.										
Was a leak observed during Test Period? Yes No **31018614 TEST 2 OF 4 : 41918944**


If "Yes", Explain: _____ High Test Pressure: 970
 Low Test Pressure: 969

Certification: _____ **Date:** 11/11/2014
 Test Supervisor:  Company Representative: 
 cl_rev_3-21-14 Signature Signature

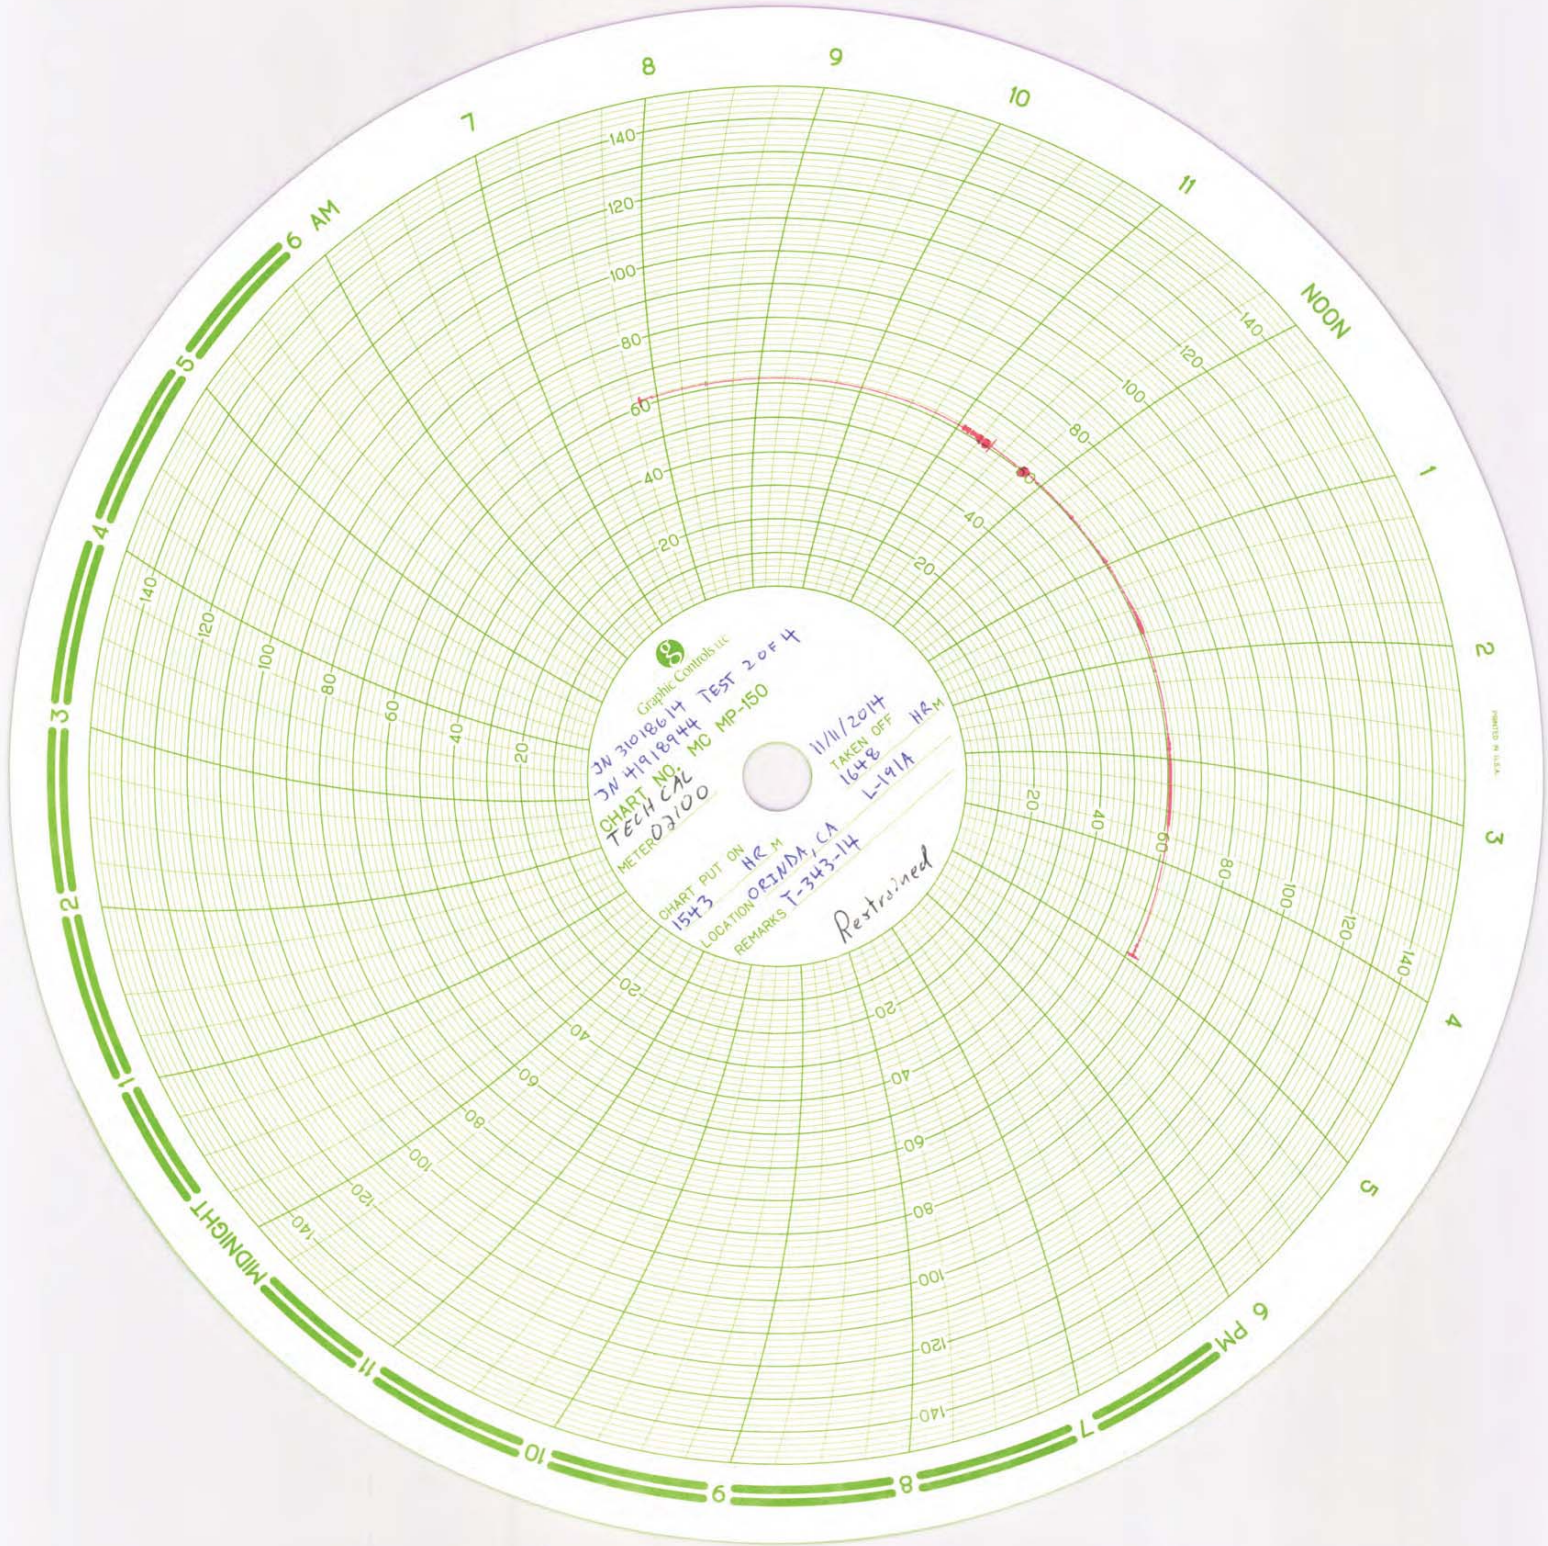

Graphic Controls Inc
 JW 31018614 TEST 2 OF 4
 JW 41918944 MC MP-150
 CHART NO. 11/11/2014
 TECH CAL TAKEN OFF
 L-191A
 CHART PUT ON HC M
 REMARKS T-343-14
 Restrained

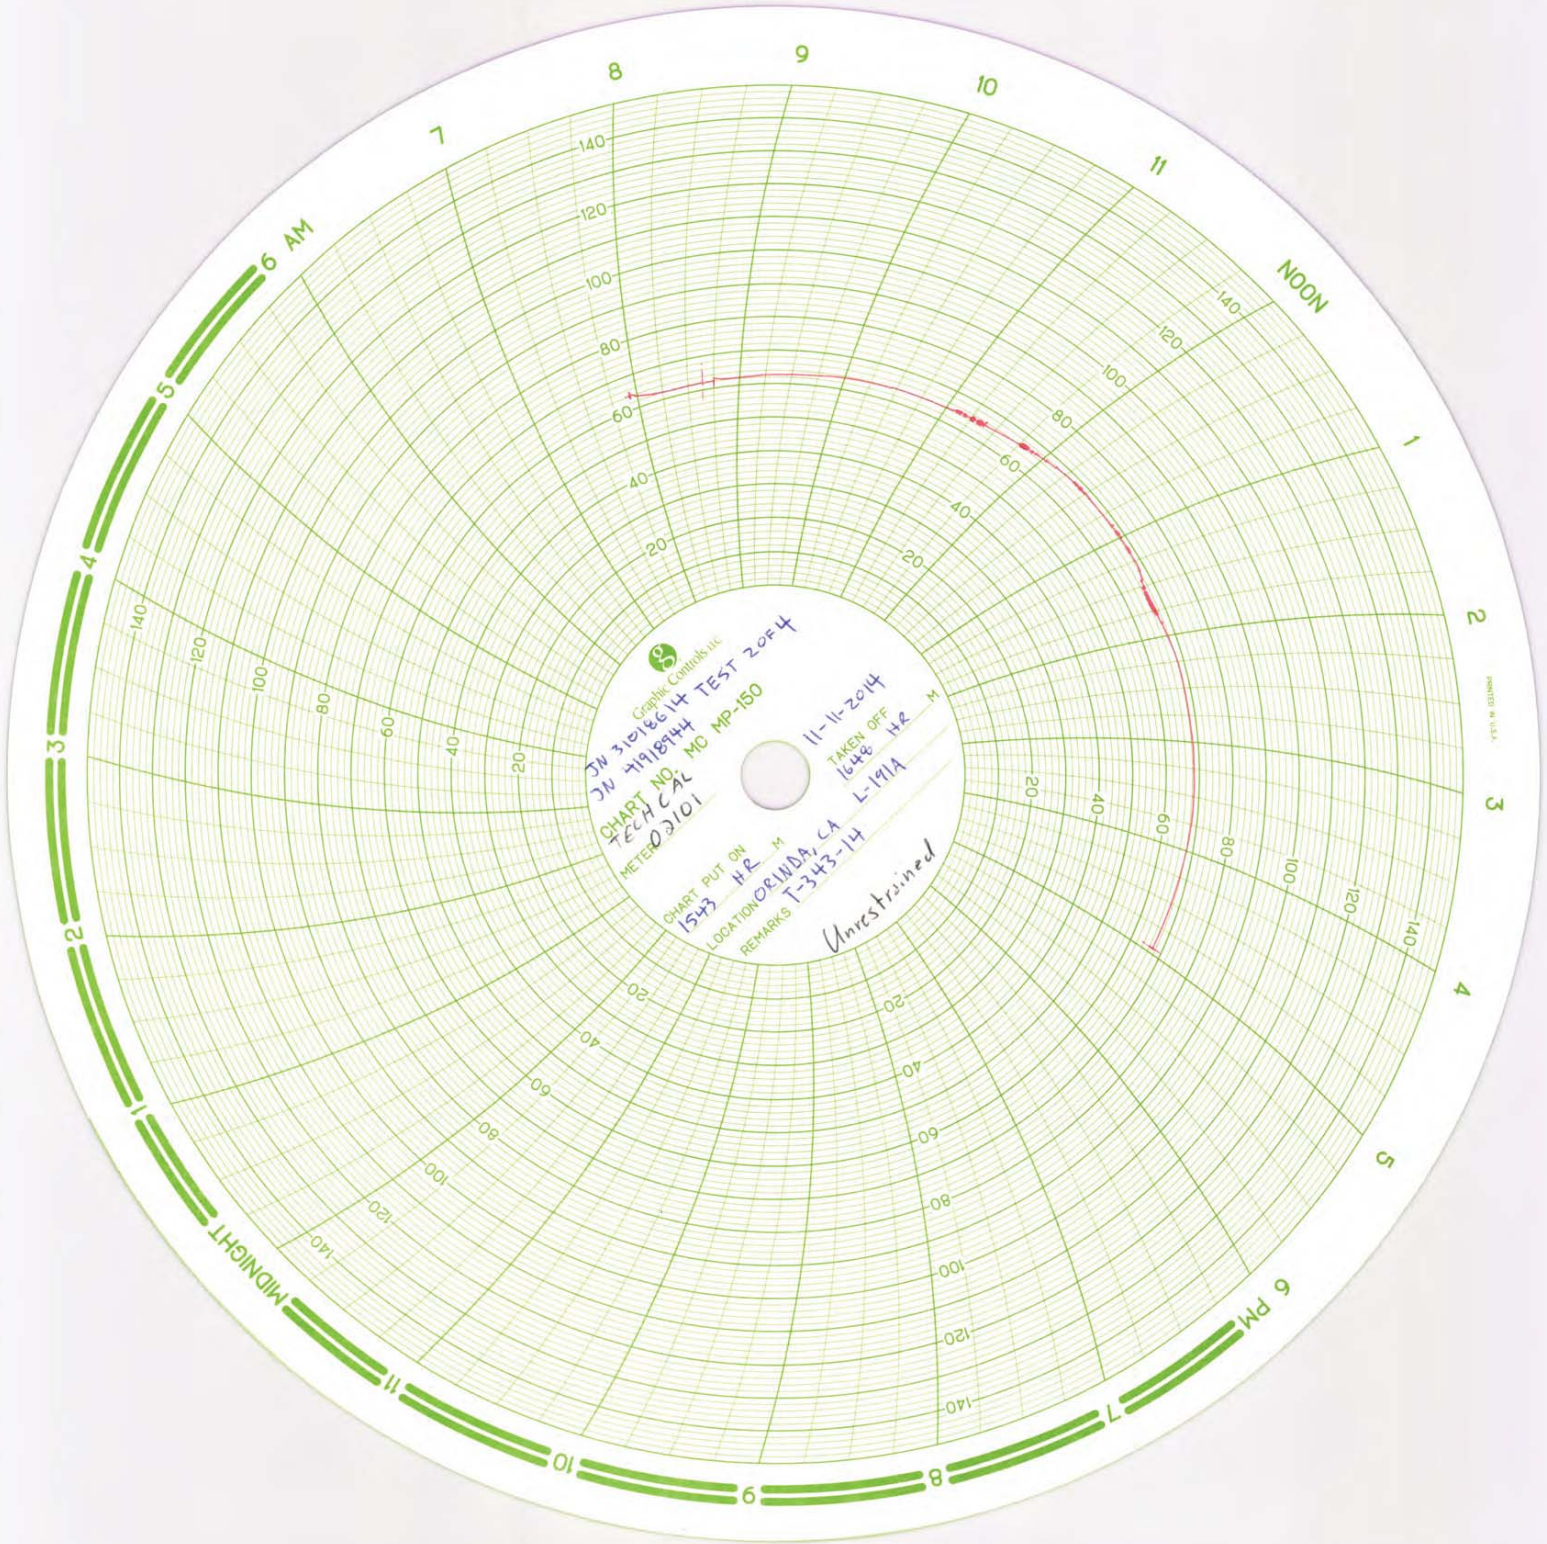

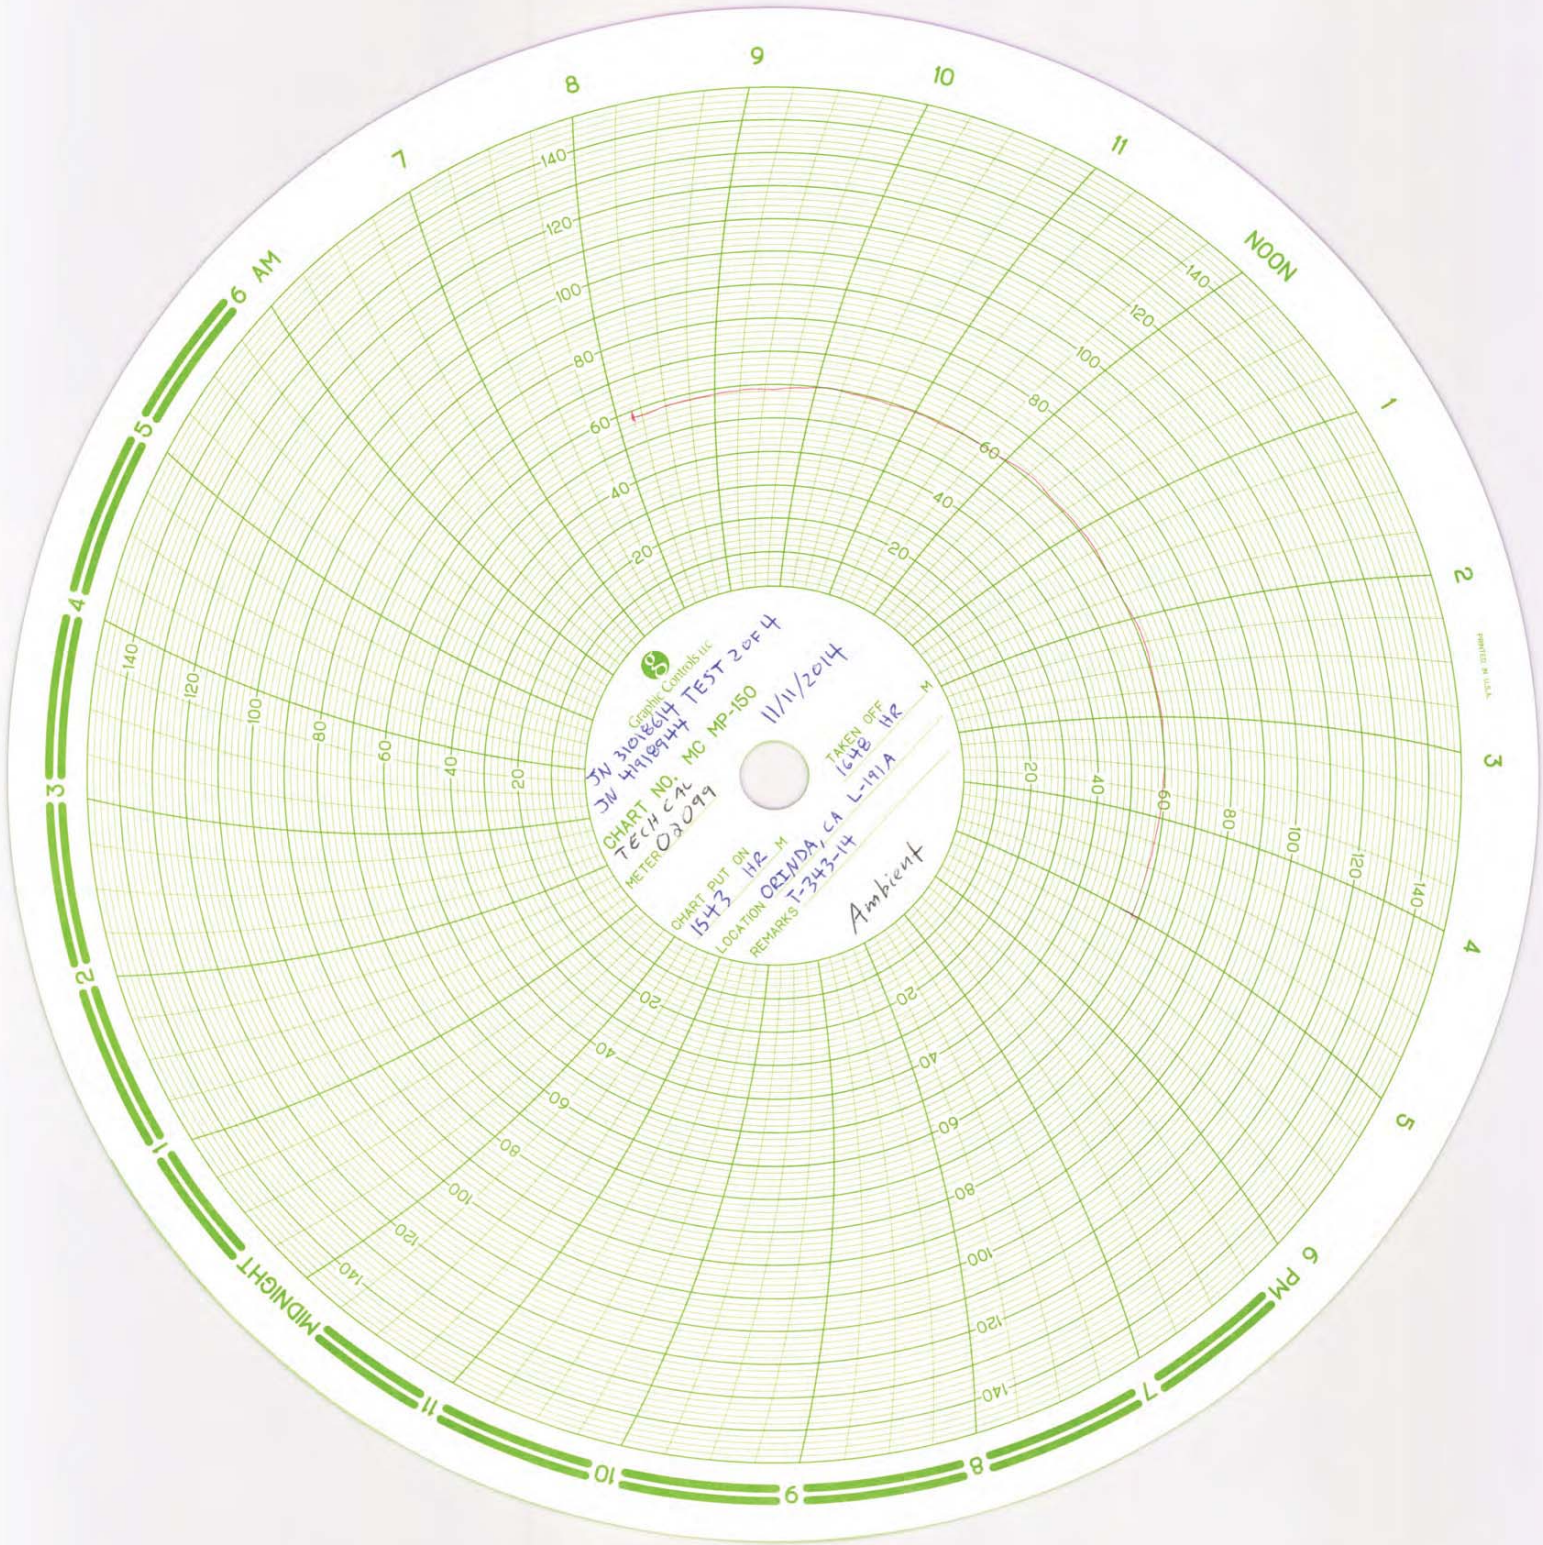

Graphic Controls Inc






REMARKS T-343-14

Ambient


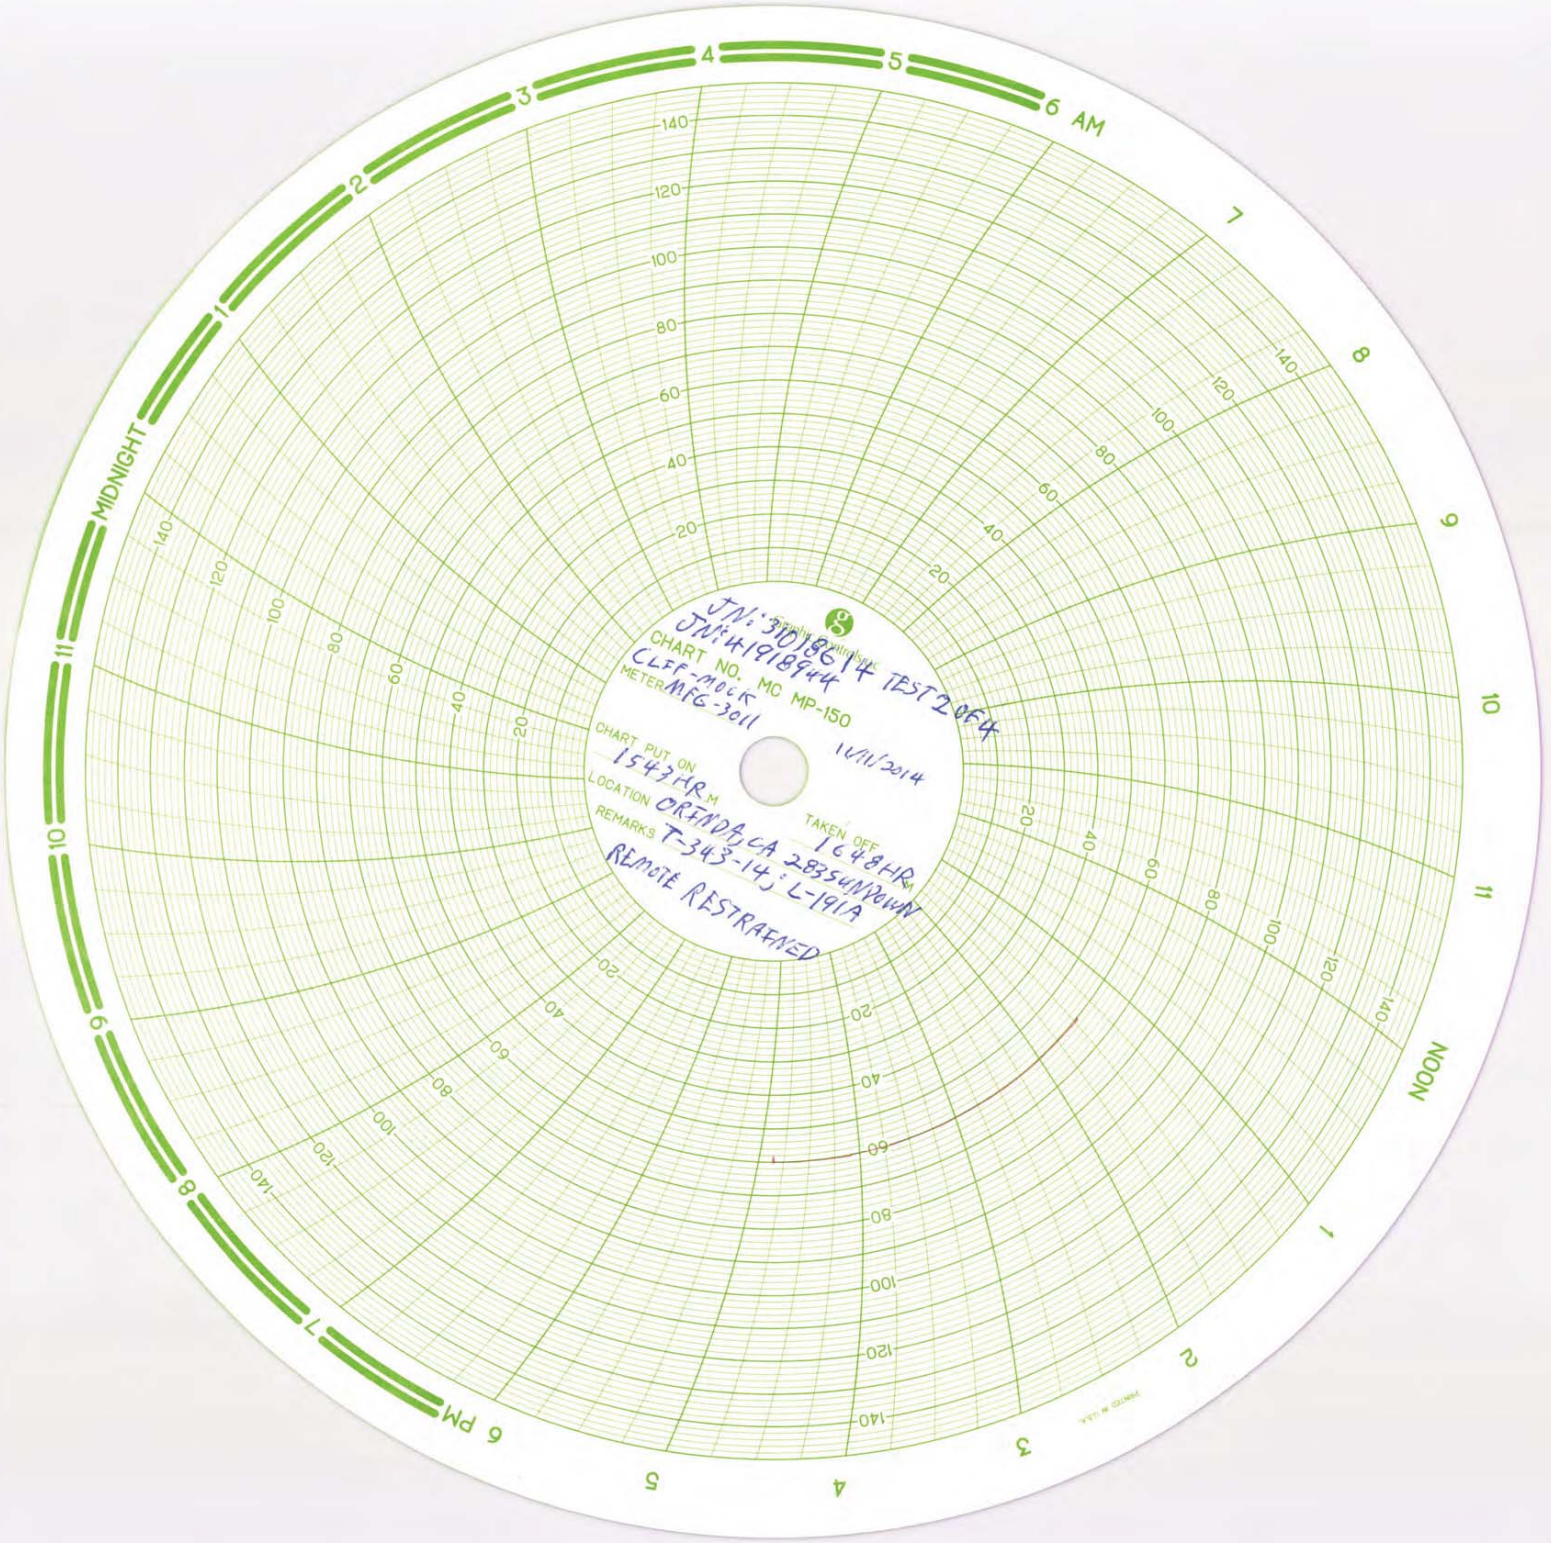

TNI: 3018614 TEST 2064
TNI: 41918944
CHART NO. MC MP-150
CLF - mock
METER MFG-3011
CHART PUT ON 1543Z
REMARKS T-343-14 L-191A
REMOTE RESTRAINED
TAKEN OFF 1648Z 11/11/2014

TOTALS BY LOCATION

Order#	Item#	Description	LOCATION:		LOC A TEST HEAD,	LOC A, DET 3,	LOC D ADDED SITE 1,	LOC D ADDED SITE 2,	LOC D, DET 24,	LOC E, DET 9,	LOC F ANOMALY,	LOC F, DET 12,	LOC F, SEC B,	LOC G, DET 13,	LOC O,	LOC O TEST HEAD,	TEST BULLET,	V-1 GAUGE LINES,
			TOTAL SUM:	UNIT	ORINDA	ORINDA	ORINDA	ORINDA	ORINDA	ORINDA	ORINDA	ORINDA	ORINDA	ORINDA	ORINDA	ORINDA	ORINDA	ORINDA
			Sum	Sum	Sum	Sum	Sum	Sum	Sum	Sum	Sum	Sum	Sum	Sum	Sum	Sum	Sum	Sum
31018614	101	8" x 0.322", GR-B, SMLS, BARE	11.07	ft.	0	6.03	0	0	0	0	0	0	0	5.04	0	0	0	0
31018614	102	8" x 0.250", X-42, HFW, BARE	2.97	ft.	0	0	0	0	0	0	0	0	0	1.55	1.42	0	0	0
31018614	104	6" x 0.280", GR-B, SMLS, BARE	24.23	ft.	0	0	0	0	13.50	0	0	6.94	3.79	0	0	0	0	0
31018614	105	3" x 0.216", GR-B, SMLS, BARE	1.16	ft.	0	0	0	0	0	0	0	0	0	0	1.16	0	0	0
31018614	106	2" x 0.154", GR-B, SMLS, BARE	9.14	ft.	0	0	0	0	0	0	0	0	0	0	9.14	0	0	0
31018614	107	3/4" x 0.154", GR-B, SMLS, BARE	12.34	ft.	0	0	0	0	0	0	0	0	0	0	0	0	0	12.34
31018614	111	ELL 90°, 8" x 0.322", GR-B	2.00	ft.	0	2.00	0	0	0	0	0	0	0	0	0	0	0	0
31018614	112	ELL 45°, 8" x 0.322", GR-B	0.40	ft.	0	0.40	0	0	0	0	0	0	0	0	0	0	0	0
31018614	115	ELL 90°, 6" x 0.280", GR-B	7.62	ft.	0	0	1.01	2.78	0	0.46	0	0	3.00	0.37	0	0	0	0
31018614	115S	ELL 90°, 6" x 0.280", GR-B	0.42	ft.	0	0	0	0	0	0.42	0	0	0	0	0	0	0	0
31018614	116	ELL 45°, 6" x 0.280", GR-B	3.08	ft.	0	0	0	0	2.48	0.30	0	0	0	0.30	0	0	0	0
31018614	116S	ELL 45°, 6" x 0.280", GR-B	0.60	ft.	0	0	0.30	0	0	0.30	0	0	0	0	0	0	0	0
31018614	117	ELL 45°, 3/4" x 0.154", #3000	0.96	ft.	0	0	0	0	0	0	0	0	0	0	0	0	0	0.96
31018614	121	RED, 8" x 6", STD WT, GR-B	0.50	ft.	0	0	0	0	0	0	0	0	0	0.50	0	0	0	0
31018614	122	RED, 3" x 2", STD WT, GR-B	0.56	ft.	0	0	0	0	0	0	0	0	0	0	0.56	0	0	0
31018614	126	TEE, 8" x 3", STD WT, GR-B	2.34	ft.	0	0	0	0	0	0	0	0	0	0	2.34	0	0	0
31018614	126S	TEE, 8" x 3" STD, BRANCH, GR-B	1.16	ft.	0	0	0	0	0	0	0	0	0	0	1.16	0	0	0
31018614	165	NIPPLE, 3/4" x 1/2" x 3", GR-B	0.50	ft.	0	0	0	0	0	0	0	0	0	0	0	0	0	0.50
31018614	201	8" BALL VALVE, ANSI 300	1.67	ft.	0	0	0	0	0	0	0	0	0	0	1.67	0	0	0
31018614	C	2" COUPLING, SOCKETWELD	0.34	ft.	0	0	0	0	0	0	0	0	0	0	0.34	0	0	0
31018614	D	6" x 0.280", GR-B, SMLS, FBE	105.84	ft.	0	0	5.07	7.42	87.13	0	0	0	0	6.22	0	0	0	0
41918944	101	8" x 0.322", GR-B, SMLS, BARE	14.74	ft.	13.71	0	0	0	0	0	0	0	0	0	0	1.03	0	0
41918944	102	8" x 0.250", X-42, HFW, BARE	15.01	ft.	0	0	0	0	0	0	0	0	0	0	15.01	0	0	0
41918944	104	6" x 0.280", GR-B, SMLS, BARE	2.86	ft.	0	0	0	0	0	0	0	0	0	0	0	2.86	0	0
41918944	111	ELL 90°, 8" x 0.322", GR-B	8.00	ft.	4.00	0	0	0	0	0	0	0	0	0	0	4	0	0
41918944	112	ELL 45°, 8" x 0.322", GR-B	0.16	ft.	0.16	0	0	0	0	0	0	0	0	0	0	0	0	0
41918944	115	ELL 90°, 6" x 0.280", GR-B	0.62	ft.	0	0	0	0	0	0	0	0	0	0	0	0	0.62	0
41918944	115S	ELL 90°, 6" x 0.280", GR-B	0.62	ft.	0	0	0	0	0	0	0	0	0	0	0	0	0.62	0
41918944	116	ELL 45°, 6" x 0.280", GR-B	1.24	ft.	0	0	0	0	0	0	0	0	0	0	0	0	1.24	0
41918944	161	CAP, 6" x 0.280", GR-B	0.58	ft.	0	0	0	0	0	0	0	0	0	0	0	0	0.58	0
41918944	D	6" x 0.280", GR-B, SMLS, FBE	15.82	ft.	0	0	0	0	0	0	5.38	0	0	0	0	0	10.44	0



RCP, Inc

801 Louisiana, Ste.200
Houston, Texas 77002
(713)655-8080
idecker@rcp.com

November 11, 2014

Pacific Gas and Electric Company
6121 Bollinger Canyon RD
San Ramon CA 94583
Attention: Mark Cabral, Aziza Tarin

Test Contractor: ARB – 41918944 Test 2
31018614 Test 2
Asset Owner: Pacific Gas and Electric Company – 41918944 Test 2
31018614 Test 2
Construction Contractor: ARB – 41918944 Test 2
31018614 Test 2
Test Section: PG&E T-343-14 Test 2, L-191A, MP 0.002 - 2.97
Test Date: November 11, 2014
Certificate Number: RCP J00110 - T-343-14 Test 2, L-191A, MP 0.002 - 2.97

To whom it may concern,

This letter is to certify that the Water test performed on pipe owned by Pacific Gas and Electric Company and tested by ARB met the requirements of the Code of Federal Regulations, Title 49, Part 192, Subpart J (Class 3).

The test segment was subjected to a spike pressure test of 1095 psig (at the test point) for 15 minutes, without observed leakage or yielding of the pipe segment. The 15 minute spike test and subsequent pressure reduction with volume bleed was included and is part of the 1.08 hour test duration period.

This Hydrostatic Pressure test was completed successfully. Pressure was maintained on the test facilities in excess of 1.08 continuous hours without evidence of a leak failure. Water was the test medium. At the highest elevation point in the test section, the calculated test pressure was 689 psig and the MAOP supported by the test, per DOT Part 192 Subpart J, can be as high as 459 psig. The MAOP established by this test is sufficient to qualify for Pacific Gas and Electric Company's desired MAOP of 283 psig.

Pressure decreased 126 psi during the test. After conclusion of the spike test, 2,755.2 ounces of fluid was intentionally released from the test section, reducing pressure by 123 psig. Net corrected volumetric change from beginning of the test to the end of the test is calculated to be 140.87 ounces, loss, which is equivalent to a 0.33 °F change in pipe temperature and within the error attributed to the temperature measurement instrumentation utilized.

Test pressure remained steady and no leaks were observed. The volumetric loss is attributed to the error characteristic of the temperature measurement instrumentation utilized.

Sincerely,

Ryan A. Maurer

cc: file



Hydrostatic Pressure Test Certification

Company	Pacific Gas and Electric Company	Job Number	41918944 Test 231018614 Test 2
Construction Co.	ARB	Job Number	41918944 Test 231018614 Test 2
Hydro. Test Co.	ARB	Project No.	41918944 Test 231018614 Test 2
Test Section	PG&E T-343-14 Test 2, L-191A, MP 0.002 - 2.97	Test Fluid = Water	
File Name	RCP J00110 - T-343-14 Test 2, L-191A, MP 0.002 - 2.97		

Water Test Pressure

APPLICABLE CODE FOR CERTIFICATION:	Code of Federal Regulations, Title 49, Part 192, Subpart J (Class 3)	Test Date:	11-Nov-14
------------------------------------	--	------------	-----------

This is to certify that the pipeline or pipeline section(s) described below was hydrostatically pressure tested in accordance with the following procedure.

Pipeline:	PG&E T-343-14 Test 2, L-191A, MP 0.002 - 2.97
From:	MP 0.00
To:	MP 2.97

Pipe Data

Segment	Length	Diameter	Wall Thickness	Specification	100% SMYS	
1	101	17.98 ft	8.625 in.	0.322 in.	API5L-Grade B, SM, Arc Weld, Steel	2,613 psi
2	104	141.79 ft	8.625 in.	0.280 in.	API5L-Grade B, SM, Arc Weld, Steel	2,958 psi
3	102	2.97 ft	8.625 in.	0.250 in.	API5L-X42, ERW-HF, Arc Weld, Steel	2,435 psi
4	105	2.88 ft	3.500 in.	0.216 in.	API5L-Grade B, SM, Arc Weld, Steel	4,320 psi
5	106	9.48 ft	2.375 in.	0.154 in.	API5L-Grade B, SM, Arc Weld, Steel	4,539 psi
6	107	13.80 ft	1.050 in.	0.154 in.	API5L-Grade B, SM, Arc Weld, Steel	10,267 psi
7	101	22.90 ft	8.625 in.	0.322 in.	API5L-Grade B, SM, Arc Weld, Steel	2,613 psi
8	104	21.74 ft	8.625 in.	0.280 in.	API5L-Grade B, SM, Arc Weld, Steel	2,958 psi
9	102	15.01 ft	8.625 in.	0.250 in.	API5L-X42, ERW-HF, Arc Weld, Steel	2,435 psi
10	1	9959.32 ft	8.625 in.	0.322 in.	API5L-X42, ERW-LF, Arc Weld, Steel	3,136 psi
11	2	76.92 ft	8.625 in.	0.322 in.	API5L-Grade B, SM, Arc Weld, Steel	2,613 psi
12	5	5748.43 ft	8.625 in.	0.280 in.	API5L-Grade B, SM, Arc Weld, Steel	2,958 psi
13	6	78.10 ft	8.625 in.	0.188 in.	API5L-X42, ERW-LF, Arc Weld, Steel	2,384 psi
14	16	60.00 ft	1.050 in.	0.113 in.	API5L-Grade B, SM, Arc Weld, Steel	7,533 psi
15	4	1501.12 ft	8.625 in.	0.172 in.	API5L-X42, ERW-LF, Arc Weld, Steel	1,675 psi
16	14	41.00 ft	1.050 in.	0.113 in.	28ksmys, FBW, Arc Weld, Steel	6,027 psi
17	15	18.00 ft	1.050 in.	0.113 in.	25ksmys, FBW, Arc Weld, Steel	5,381 psi
18	TH	6.50 ft	8.625 in.	0.500 in.	API5L-Grade B, SM, Arc Weld, Steel	4,058 psi
19	TH	6.50 ft	8.625 in.	0.500 in.	API5L-Grade B, SM, Arc Weld, Steel	4,058 psi

Initial Test Conditions

Pressure at Test Point:	1,095 psig	Date/Time:	11-Nov-2014 15:43	Pipe Temperature	
Ambient Temperature:	60.0 °F	Elevation @ Test Point:	726.0 ft	Unrestrained:	68.0 °F
Pressure @ High Point (Cal/Measure):	816 psig	Elevation @ High Point:	1,370.0 ft	Restrained:	61.0 °F
Pressure @ Low Point (Cal/Measure):	1,110 psig	Elevation @ Low Point:	691.0 ft	Location:	172+37
				Location:	04+65
				Location:	151+09

Final Test Conditions

Pressure at Test Point:	969 psig	Date/Time:	11-Nov-2014 16:48	Pipe Temperature	
Ambient Temperature:	58.0 °F	Elevation @ Test Point:	726.0 ft	Unrestrained:	67.0 °F
Pressure @ High Point (Cal/Measure):	690 psig	Elevation @ High Point:	1,370.0 ft	Restrained:	62.0 °F
Pressure @ Low Point (Cal/Measure):	984 psig	Elevation @ Low Point:	691.0 ft	Location:	172+37
				Location:	04+65
				Location:	151+09

Total Fluid Injected:		Total Fluid Withdrawn:		2755.20 fluid ounces	Volume Loss
Net Change in Volume of the Test Section ± (+ Gain, - Loss):	(140.67) oz	Loss	(0.0028)%	(0.326) °F equivalent	

Test Duration:	1.08 hours
----------------	------------

Minimum Test Pressure:	969 psig	Test Point	689 psig	Min Elevation	984 psig
Maximum Test Pressure:	1,095 psig	Max Elevation	815 psig		1,111 psig
% SMYS:	27.0%		7.9%		66.3%
Test Segment Observed % SMYS:	Minimum	7.9%	Maximum		66.3%

DOT Part 192 Maximum Allowable Operating Pressure	D ₁	Design MAOP	T _r	Minimum Test Pressure (Calculated/Measured)	Test MAOP	MAOP
	0.5	838 psig	1.5	689 psig	459 psig	459 psig


The MAOP established by this test is sufficient to qualify for Pacific Gas and Electric Company's desired MAOP of 283 psig.

Is Test to Yield Utilized to Establish MAOP?	No	TTY MAOP @ High Elevation	TTY MAOP @ Test Point
ASME B31.8S - Integrity Assessment Interval	10 years	Desired MAOP % SMYS	16.89%
		ASME B31.8S Minimum Test Factor	2.20

Were leaks observed?	No	Explain:
----------------------	----	----------

Acceptable Hydrostatic Test?	Yes	<p>The test segment was subjected to a spike pressure test of 1095 psig (at the test point) for 15 minutes, without observed leakage or yielding of the pipe segment. The 15 minute spike test and subsequent pressure reduction with volume bleed was included and is part of the 1.08 hour test duration period.</p> <p>No leaks were observed during the test period. The test section included 17,543 feet of buried and 202 feet of exposed pipe. Pressure lost 126 psi during the test. The buried pipe segment gained 1°F fluid temperature and the exposed pipe segment lost 1°F.</p> <p>After conclusion of the spike test, 2,755.2 ounces of fluid was intentionally released from the test section, reducing pressure by 123 psig. Net corrected volumetric change from beginning of the test to the end of the test is calculated to be 140.87 ounces, loss, which is equivalent to a 0.33 °F change in pipe temperature and within the error attributed to the temperature measurement instrumentation utilized.</p> <p>Test pressure remained steady and no leaks were observed. The volumetric loss is attributed to the error characteristic of the temperature measurement instrumentation utilized.</p>
------------------------------	-----	---

Remarks	
---------	--

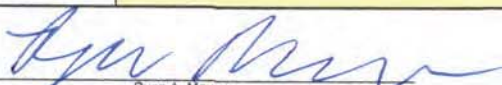
 Ryan A. Maurer
 11-Nov-14



Dead Weight Log Sheet

Owner Company	Pacific Gas and Electric Company	Job Number	41918944 Test 2 31018614 Test 2
Construction Co.	ARB	Job Number	41918944 Test 2 31018614 Test 2
Testing Co.	ARB	Project No.	18944 Test 231018614 Test
Test Section	PG&E T-343-14 Test 2, L-191A, MP 0.002 - 2.97		
File Name	RCP J00110 - T-343-14 Test 2, L-191A, MP 0.002 - 2.97		
Test Fluid = Water			

Date		11-Nov-14		Test Log					
Log No.	Test Period		Test Pressure	Temperature °F			Remarks		
	Date	Time		Ambient	Pipe				
					Unrestrained	Restrained	Comment	Bleed	Inject
1	11-Nov-2014	15:02	716 psig	60 °F	68 °F	61 °F	Start Spike		
2	11-Nov-2014	15:03	726 psig	60 °F	68 °F	61 °F	Inject		234 oz.
3	11-Nov-2014	15:04	736 psig	60 °F	68 °F	61 °F	Inject		225 oz.
4	11-Nov-2014	15:05	746 psig	60 °F	68 °F	61 °F	Inject		216 oz.
5	11-Nov-2014	15:06	756 psig	60 °F	68 °F	61 °F	Inject		216 oz.
6	11-Nov-2014	15:07	766 psig	60 °F	68 °F	61 °F	Inject		216 oz.
7	11-Nov-2014	15:08	776 psig	60 °F	68 °F	61 °F	Inject		216 oz.
8	11-Nov-2014	15:09	786 psig	60 °F	68 °F	61 °F	Inject		216 oz.
9	11-Nov-2014	15:10	796 psig	60 °F	68 °F	61 °F	Inject		225 oz.
10	11-Nov-2014	15:11	806 psig	60 °F	68 °F	61 °F	Inject		225 oz.
11	11-Nov-2014	15:13	816 psig	60 °F	68 °F	61 °F	Inject		234 oz.
12	11-Nov-2014	15:14	826 psig	60 °F	68 °F	61 °F	Inject		225 oz.
13	11-Nov-2014	15:15	836 psig	60 °F	68 °F	61 °F	Inject		243 oz.
14	11-Nov-2014	15:16	846 psig	60 °F	68 °F	61 °F	Inject		225 oz.
15	11-Nov-2014	15:17	856 psig	60 °F	68 °F	61 °F	Inject		234 oz.
16	11-Nov-2014	15:18	866 psig	60 °F	68 °F	61 °F	Inject		234 oz.
17	11-Nov-2014	15:19	876 psig	60 °F	68 °F	61 °F	Inject		225 oz.
18	11-Nov-2014	15:20	886 psig	60 °F	68 °F	61 °F	Inject		234 oz.
19	11-Nov-2014	15:21	896 psig	60 °F	68 °F	61 °F	Inject		225 oz.
20	11-Nov-2014	15:22	906 psig	60 °F	68 °F	61 °F	Inject		234 oz.
21	11-Nov-2014	15:24	916 psig	60 °F	68 °F	61 °F	Inject		234 oz.
22	11-Nov-2014	15:25	926 psig	60 °F	68 °F	61 °F	Inject		216 oz.
23	11-Nov-2014	15:26	936 psig	60 °F	68 °F	61 °F	Inject		207 oz.
24	11-Nov-2014	15:27	946 psig	60 °F	68 °F	61 °F	Inject		216 oz.
25	11-Nov-2014	15:28	956 psig	60 °F	68 °F	61 °F	Inject		225 oz.
26	11-Nov-2014	15:29	966 psig	60 °F	68 °F	61 °F	Inject		216 oz.
27	11-Nov-2014	15:30	976 psig	60 °F	68 °F	61 °F	Inject		225 oz.
28	11-Nov-2014	15:31	986 psig	60 °F	68 °F	61 °F	Inject		216 oz.
29	11-Nov-2014	15:32	996 psig	60 °F	68 °F	61 °F	Inject		225 oz.
30	11-Nov-2014	15:33	1,006 psig	60 °F	68 °F	61 °F	Inject		225 oz.
31	11-Nov-2014	15:35	1,016 psig	60 °F	68 °F	61 °F	Inject		198 oz.
32	11-Nov-2014	15:36	1,026 psig	60 °F	68 °F	61 °F	Inject		243 oz.
33	11-Nov-2014	15:37	1,036 psig	60 °F	68 °F	61 °F	Inject		234 oz.
34	11-Nov-2014	15:38	1,046 psig	60 °F	68 °F	61 °F	Inject		216 oz.
35	11-Nov-2014	15:39	1,056 psig	60 °F	68 °F	61 °F	Inject		234 oz.
36	11-Nov-2014	15:40	1,066 psig	60 °F	68 °F	61 °F	Inject		225 oz.
37	11-Nov-2014	15:41	1,076 psig	60 °F	68 °F	61 °F	Inject		225 oz.
38	11-Nov-2014	15:42	1,086 psig	60 °F	68 °F	61 °F	Inject		216 oz.
39	11-Nov-2014	15:43	1,095 psig	60 °F	68 °F	61 °F	Inject		198 oz.
40	11-Nov-2014	15:43	1,095 psig	60 °F	68 °F	61 °F	On Test		
41	11-Nov-2014	15:48	1,094 psig	60 °F	68 °F	61 °F			
42	11-Nov-2014	15:53	1,093 psig	59 °F	68 °F	61 °F			
43	11-Nov-2014	15:58	1,093 psig	59 °F	68 °F	61 °F	End Spike		
44	11-Nov-2014	15:58	970 psig	59 °F	68 °F	61 °F	Bleed Spike	2,755 oz.	
45	11-Nov-2014	16:15	970 psig	58 °F	68 °F	61 °F			
46	11-Nov-2014	16:20	970 psig	58 °F	68 °F	62 °F			
47	11-Nov-2014	16:25	970 psig	58 °F	68 °F	62 °F			
48	11-Nov-2014	16:30	970 psig	58 °F	68 °F	62 °F			
49	11-Nov-2014	16:35	970 psig	58 °F	68 °F	62 °F			
50	11-Nov-2014	16:40	970 psig	58 °F	68 °F	62 °F			
51	11-Nov-2014	16:45	970 psig	58 °F	67 °F	62 °F			
52	11-Nov-2014	16:48	969 psig	58 °F	67 °F	62 °F	End of Test		



Dead Weight Log Sheet

Owner Company	Pacific Gas and Electric Company	Job Number	41918944 Test 2 31018614 Test 2
Construction Co.	ARB	Job Number	41918944 Test 2 31018614 Test 2
Testing Co.	ARB	Project No.	18944 Test 231018614 Test
Test Section	PG&E T-343-14 Test 2, L-191A, MP 0.002 - 2.97		
File Name	RCP J00110 - T-343-14 Test 2, L-191A, MP 0.002 - 2.97		
Test Fluid = Water			

Date	11-Nov-14	Test Log
------	-----------	-----------------

Log No.	Test Period		Test Pressure	Temperature °F			Remarks		
	Date	Time		Ambient	Pipe		Comment	Bleed	Inject
					Unrestrained	Restrained			

Spike Test		8,490 oz.
Hydrostatic Test	2,755.2 oz.	

Were leaks observed during the test period?	Exposed and buried pipe, no leaks observed.	Comment		High Test Pressure:	1,095 psig
				Low Test Pressure:	969 psig



Pipe Segment Volume Calculations

Company	Pacific Gas and Electric Company	Job Number	41918944 Test 231018614 Test 2
Construction Co.	ARB	Job Number	41918944 Test 2 31018614 Test 2
Hydro. Test Co.	ARB	Project No.	41918944 Test 231018614 Test 2
Test Section	PG&E T-343-14 Test 2, L-191A, MP 0.002 - 2.97	WATER	
File Name	RCP J00110 - T-343-14 Test 2, L-191A, MP 0.002 - 2.97		

General Pipe Data

Description	Segment							
	1	2	3	4	5	6	7	8
Restrained or Unrestrained?	Unrestrained	Unrestrained	Unrestrained	Unrestrained	Unrestrained	Unrestrained	Restrained	Restrained
Outside Diameter	8.625 in.	6.625 in.	8.625 in.	3.500 in.	2.375 in.	1.050 in.	8.625 in.	6.625 in.
Wall Thickness	0.322 in.	0.280 in.	0.250 in.	0.216 in.	0.154 in.	0.154 in.	0.322 in.	0.280 in.
Inside Diameter	7.981 in.	6.065 in.	8.125 in.	3.068 in.	2.067 in.	0.742 in.	7.981 in.	6.065 in.
Spec./Grade	API5L-Grade B	API5L-Grade B	API5L-X42	API5L-Grade B	API5L-Grade B	API5L-Grade B	API5L-Grade B	API5L-Grade B
Length Unrestrained	18 ft	142 ft	3 ft	3 ft	9 ft	14 ft		
Length Restrained							23 ft	22 ft
Temperature -- On Test	68 °F	68 °F	68.0 °F	68.0 °F	68.0 °F	68.0 °F	61.0 °F	61.0 °F
Temperature -- End of Test	67 °F	67 °F	67.0 °F	67.0 °F	67.0 °F	67.0 °F	62.0 °F	62.0 °F
Pressure -- On Test	1,095 psig	1,095 psig	1,095 psig	1,095 psig	1,095 psig	1,095 psig	1,095 psig	1,095 psig
Pressure -- End of Test	969 psig	969 psig	969 psig	969 psig	969 psig	969 psig	969 psig	969 psig

Unrestrained Pipe

Vo	301.43 gal		Vtp1	302.54 gal		Vtp2	302.42 gal	
	38,583 oz.			38,725 oz.			38,710 oz.	
Vo Unrestrained	47 gal	213 gal	8 gal	1 gal	2 gal	0 gal		
Fwp 1	1.003356	1.003356	1.003356	1.003356	1.003356	1.003356		
Fpp 1	1.001131	1.000988	1.001483	1.000648	1.000612	1.000220		
Fpt 1	1.000146	1.000146	1.000146	1.000146	1.000146	1.000146		
Fwt 1	1.000803	1.000803	1.000803	1.000803	1.000803	1.000803		
Fpwt 1 = Fpt/Fwt	0.999343	0.999343	0.999343	0.999343	0.999343	0.999343		
Vtp 1 = Vo(Fwp)(Fpp)(Fpwt)	46.91 gal	213.58 gal	8.03 gal	1.11 gal	1.66 gal	0.31 gal		
Fwp 2	1.002969	1.002969	1.002969	1.002969	1.002969	1.002969		
Fpp 2	1.001001	1.000875	1.001312	1.000573	1.000542	1.000195		
Fpt 2	1.000127	1.000127	1.000127	1.000127	1.000127	1.000127		
Fwt 2	1.000681	1.000681	1.000681	1.000681	1.000681	1.000681		
Fpwt = Fpt/Fwt	0.999447	0.999447	0.999447	0.999447	0.999447	0.999447		
Vtp = Vo(Fwp)(Fpp)(Fpwt)	46.89 gal	213.50 gal	8.03 gal	1.11 gal	1.66 gal	0.31 gal		

Restrained Pipe

Vo	39,169.65 gal		Vtp1	39,333.34 gal		Vtp2	39,310.84 gal	
	5,013,715 oz.			5,034,668 oz.			5,031,787 oz.	
Vo Unrestrained							60 gal	33 gal
Fwp 1							1.003356	1.003356
Fpp 1							1.000827	1.000723
Fpt 1							1.000012	1.000012
Fwt 1							1.000080	1.000080
Fpwt 1 = Fpt/Fwt							0.999932	0.999932
Vtp 1 = Vo(Fwp)(Fpp)(Fpwt)							60 gal	33 gal
Fwp 2							1.002969	1.002969
Fpp 2							1.000736	1.000644
Fpt 2							1.000024	1.000024
Fwt 2							1.000181	1.000181
Fpwt = Fpt/Fwt							0.999844	0.999844
Vtp = Vo(Fwp)(Fpp)(Fpwt)							60 gal	33 gal

Combined Pipe

Vo	39,471.08 gal		Vtp1	39,635.88 gal		Vtp2	39,613.26 gal	
	5,052,298 oz.			5,073,393 oz.			5,070,497 oz.	



Pipe Segment Volume Calculations

Company	Pacific Gas and Electric Company
Construction Co.	ARB
Hydro. Test Co.	ARB
Test Section	PG&E T-343-14 Test 2, L-191A, MP 0.002 - 2.97
File Name	RCP J00110 - T-343-14 Test 2, L-191A, MP 0.002 - 2.97

General Pipe Data								
Description	Segment							
	9	10	11	12	13	14	15	16
Restrained or Unrestrained?	Restrained	Restrained	Restrained	Restrained	Restrained	Restrained	Restrained	Restrained
Outside Diameter	8.625 in.	8.625 in.	8.625 in.	8.625 in.	8.625 in.	1.050 in.	8.625 in.	1.050 in.
Wall Thickness	0.250 in.	0.322 in.	0.322 in.	0.280 in.	0.188 in.	0.113 in.	0.172 in.	0.113 in.
Inside Diameter	8.125 in.	7.981 in.	7.981 in.	8.065 in.	6.249 in.	0.824 in.	8.281 in.	0.824 in.
Spec./Grade	API5L-X42	API5L-X42	API5L-Grade B	API5L-Grade B	API5L-X42	API5L-Grade B	API5L-X42	28ksmys
Length Unrestrained								
Length Restrained	15 ft	9,959 ft	77 ft	5,748 ft	78 ft	60 ft	1,501 ft	41 ft
Temperature -- On Test	61.0 °F	61.0 °F	61.0 °F	61.0 °F	61.0 °F	61.0 °F	61.0 °F	61.0 °F
Temperature -- End of Test	62.0 °F	62.0 °F	62.0 °F	62.0 °F	62.0 °F	62.0 °F	62.0 °F	62.0 °F
Pressure -- On Test	1,095 psig	1,095 psig	1,095 psig	1,095 psig	1,095 psig	1,095 psig	1,095 psig	1,095 psig
Pressure -- End of Test	969 psig	969 psig	969 psig	969 psig	969 psig	969 psig	969 psig	969 psig

Unrestrained Pipe								
Vo								

Vo Unrestrained								
Fwp 1								
Fpp 1								
Fpt 1								
Fwt 1								
Fpwt 1 = Fpt/Fwt								
Vtp 1 = Vo(Fwp)(Fpp)(Fpwt)								
Fwp 2								
Fpp 2								
Fpt 2								
Fwt 2								
Fpwt = Fpt/Fwt								
Vtp = Vo(Fwp)(Fpp)(Fpwt)								

Restrained Pipe								
Vo								
Vo Unrestrained	40 gal	25,882 gal	200 gal	8,627 gal	124 gal	2 gal	4,200 gal	1 gal
Fwp 1	1.003356	1.003356	1.003356	1.003356	1.003356	1.003356	1.003356	1.003356
Fpp 1	1.001083	1.000827	1.000827	1.000723	1.001108	1.000246	1.001603	1.000246
Fpt 1	1.000012	1.000012	1.000012	1.000012	1.000012	1.000012	1.000012	1.000012
Fwt 1	1.000080	1.000080	1.000080	1.000080	1.000080	1.000080	1.000080	1.000080
Fpwt 1 = Fpt/Fwt	0.999932	0.999932	0.999932	0.999932	0.999932	0.999932	0.999932	0.999932
Vtp 1 = Vo(Fwp)(Fpp)(Fpwt)	41 gal	25,989 gal	201 gal	8,662 gal	125 gal	2 gal	4,220 gal	1 gal
Fwp 2	1.002969	1.002969	1.002969	1.002969	1.002969	1.002969	1.002969	1.002969
Fpp 2	1.000962	1.000736	1.000736	1.000644	1.000984	1.000222	1.001422	1.000222
Fpt 2	1.000024	1.000024	1.000024	1.000024	1.000024	1.000024	1.000024	1.000024
Fwt 2	1.000181	1.000181	1.000181	1.000181	1.000181	1.000181	1.000181	1.000181
Fpwt = Fpt/Fwt	0.999844	0.999844	0.999844	0.999844	0.999844	0.999844	0.999844	0.999844
Vtp = Vo(Fwp)(Fpp)(Fpwt)	41 gal	25,974 gal	201 gal	8,657 gal	125 gal	2 gal	4,218 gal	1 gal

Combined Pipe								
Vo								



Pipe Segment Volume Calculations

Company: Pacific Gas and Electric Company
 Construction Co.: ARB
 Hydro. Test Co.: ARB
 Test Section: PG&E T-343-14 Test 2, L-191A, MP 0.002 - 2.97
 File Name: RCP J00110 - T-343-14 Test 2, L-191A, MP 0.002 - 2.97

General Pipe Data							
Description	Segment						
	17	18	19				
Restrained or Unrestrained?	Restrained	Unrestrained	Unrestrained				
Outside Diameter	1.050 in.	8.625 in.	8.625 in.				
Wall Thickness	0.113 in.	0.500 in.	0.500 in.				
Inside Diameter	0.824 in.	7.625 in.	7.625 in.				
Spec./Grade	25ksmys	API5L-Grade B	API5L-Grade B				
Length Unrestrained		7 ft	7 ft				
Length Restrained	18 ft						
Temperature -- On Test	61.0 °F	68.0 °F	68.0 °F				
Temperature -- End of Test	62.0 °F	67.0 °F	67.0 °F				
Pressure -- On Test	1,095 psig	1,095 psig	1,095 psig				
Pressure -- End of Test	969 psig	969 psig	969 psig				
Unrestrained Pipe							
Vo							
Vo Unrestrained		15 gal	15 gal				
Fwp 1		1.003356	1.003356				
Fpp 1		1.000696	1.000696				
Fpt 1		1.000146	1.000146				
Fwt 1		1.000803	1.000803				
Fpwt 1 = Fpt/Fwt		0.999343	0.999343				
Vtp 1 = Vo(Fwp)(Fpp)(Fpwt)		15.47 gal	15.47 gal				
Fwp 2		1.002969	1.002969				
Fpp 2		1.000616	1.000616				
Fpt 2		1.000127	1.000127				
Fwt 2		1.000681	1.000681				
Fpwt = Fpt/Fwt		0.999447	0.999447				
Vtp = Vo(Fwp)(Fpp)(Fpwt)		15.47 gal	15.47 gal				
Restrained Pipe							
Vo							
Vo Unrestrained	0 gal						
Fwp 1	1.003356						
Fpp 1	1.000246						
Fpt 1	1.000012						
Fwt 1	1.000080						
Fpwt 1 = Fpt/Fwt	0.999932						
Vtp 1 = Vo(Fwp)(Fpp)(Fpwt)	1 gal						
Fwp 2	1.002969						
Fpp 2	1.000222						
Fpt 2	1.000024						
Fwt 2	1.000181						
Fpwt = Fpt/Fwt	0.999844						
Vtp = Vo(Fwp)(Fpp)(Fpwt)	1 gal						
Combined Pipe							
Vo							



Pipe Segment Volume Allowance Calculations

Company	Pacific Gas and Electric Company	Job Number	41918944 Test 231018614 Test 2
Construction Co.	ARB	Job Number	41918944 Test 2
Hydro. Test Co.	ARB	Project No.	41918944 Test 231018614 Test 2
Test Section	PG&E T-343-14 Test 2, L-191A, MP 0.002 - 2.97		WATER
File Name	RCP J00110 - T-343-14 Test 2, L-191A, MP 0.002 - 2.97		

General Pipe Data

Description	Segment							
	1	2	3	4	5	6	7	8
Restrained or Unrestrained?	Unrestrained	Unrestrained	Unrestrained	Unrestrained	Unrestrained	Unrestrained	Restrained	Restrained
Outside Diameter	8.625 in.	8.625 in.	8.625 in.	3.500 in.	2.375 in.	1.050 in.	8.625 in.	6.625 in.
Wall Thickness	0.322 in.	0.280 in.	0.250 in.	0.216 in.	0.154 in.	0.154 in.	0.322 in.	0.280 in.
Inside Diameter	7.981 in.	6.065 in.	8.125 in.	3.068 in.	2.067 in.	0.742 in.	7.981 in.	6.065 in.
Spec./Grade	API5L-Grade B	API5L-Grade B	API5L-X42	API5L-Grade B	API5L-Grade B	API5L-Grade B	API5L-Grade B	API5L-Grade B
Length Unrestrained	18 ft	142 ft	3 ft	3 ft	9 ft	14 ft		
Length Restrained							23 ft	22 ft
Temperature -- On Test	67.0 °F	67.0 °F	67.0 °F	67.0 °F	67.0 °F	67.0 °F	61.0 °F	61.0 °F
Temperature -- End of Test	68.0 °F	68.0 °F	68.0 °F	68.0 °F	68.0 °F	68.0 °F	62.0 °F	62.0 °F
Pressure -- On Test	1,032 psig	1,032 psig	1,032 psig	1,032 psig	1,032 psig	1,032 psig	1,032 psig	1,032 psig
Pressure -- End of Test	1,032 psig	1,032 psig	1,032 psig	1,032 psig	1,032 psig	1,032 psig	1,032 psig	1,032 psig

Unrestrained Pipe

	301.43 gal		302.50 gal		302.47 gal
Vo	38,583 oz.	Vtp1	38,720 oz.	Vtp2	38,716 oz.
Vo Unrestrained	47 gal	213 gal	8 gal	1 gal	2 gal
Fwp 1	1.003163	1.003163	1.003163	1.003163	1.003163
Fpp 1	1.001066	1.000931	1.001398	1.000611	1.000577
Fpt 1	1.000127	1.000127	1.000127	1.000127	1.000127
Fwt 1	1.000681	1.000681	1.000681	1.000681	1.000681
Fpwt 1 = Fpt/Fwt	0.999447	0.999447	0.999447	0.999447	0.999447
Vtp 1 = Vo(Fwp)(Fpp)(Fpwt)	46.90 gal	213.55 gal	8.03 gal	1.11 gal	1.66 gal
Fwp 2	1.003163	1.003163	1.003163	1.003163	1.003163
Fpp 2	1.001066	1.000931	1.001398	1.000611	1.000577
Fpt 2	1.000146	1.000146	1.000146	1.000146	1.000146
Fwt 2	1.000803	1.000803	1.000803	1.000803	1.000803
Fpwt = Fpt/Fwt	0.999343	0.999343	0.999343	0.999343	0.999343
Vtp = Vo(Fwp)(Fpp)(Fpwt)	46.89 gal	213.53 gal	8.03 gal	1.11 gal	1.66 gal

Restrained Pipe

	39,169.65 gal		39,323.75 gal		39,320.43 gal
Vo	5,013,715 oz.	Vtp1	5,033,440 oz.	Vtp2	5,033,014 oz.
Vo Restrained					60 gal
Fwp 1					1.003163
Fpp 1					1.000779
Fpt 1					1.000012
Fwt 1					1.000080
Fpwt 1 = Fpt/Fwt					0.999932
Vtp 1 = Vo(Fwp)(Fpp)(Fpwt)					60 gal
Fwp 2					1.003163
Fpp 2					1.000783
Fpt 2					1.000024
Fwt 2					1.000181
Fpwt = Fpt/Fwt					0.999844
Vtp = Vo(Fwp)(Fpp)(Fpwt)					60 gal

Combined Pipe

	39,471.08 gal		39,626.25 gal		39,622.89 gal
Vo	5,052,298 oz.	Vtp1	5,072,159 oz.	Vtp2	5,071,730 oz.
1 °F Change	3.35 gal	429.27 oz.			



Pipe Segment Volume Allowance Calculations

Company	Pacific Gas and Electric Company
Construction Co.	ARB
Hydro. Test Co.	ARB
Test Section	PG&E T-343-14 Test 2, L-191A, MP 0.002 - 2.97
File Name	RCP J00110 - T-343-14 Test 2, L-191A, MP 0.002 - 2.97

General Pipe Data								
Description	Segment							
	9	10	11	12	13	14	15	16
Restrained or Unrestrained?	Restrained	Restrained	Restrained	Restrained	Restrained	Restrained	Restrained	Restrained
Outside Diameter	8.625 in.	8.625 in.	8.625 in.	6.625 in.	6.625 in.	1.050 in.	8.625 in.	1.050 in.
Wall Thickness	0.250 in.	0.322 in.	0.322 in.	0.280 in.	0.188 in.	0.113 in.	0.172 in.	0.113 in.
Inside Diameter	8.125 in.	7.981 in.	7.981 in.	6.065 in.	6.249 in.	0.824 in.	8.281 in.	0.824 in.
Spec./Grade	API5L-X42	API5L-X42	API5L-Grade B	API5L-Grade B	API5L-X42	API5L-Grade B	API5L-X42	28ksmys
Length Unstrained								
Length Restrained	15 ft	9,959 ft	77 ft	5,748 ft	78 ft	60 ft	1,501 ft	41 ft
Temperature -- On Test	61.0 °F	61.0 °F	61.0 °F	61.0 °F	61.0 °F	61.0 °F	61.0 °F	61.0 °F
Temperature -- End of Test	62.0 °F	62.0 °F	62.0 °F	62.0 °F	62.0 °F	62.0 °F	62.0 °F	62.0 °F
Pressure -- On Test	1,032 psig	1,032 psig	1,032 psig	1,032 psig	1,032 psig	1,032 psig	1,032 psig	1,032 psig
Pressure -- End of Test	1,032 psig	1,032 psig	1,032 psig	1,032 psig	1,032 psig	1,032 psig	1,032 psig	1,032 psig

Unrestrained Pipe								
Vo								
Vo Unrestrained								
Fwp 1								
Fpp 1								
Fpt 1								
Fwt 1								
Fpwt 1 = Fpt/Fwt								
Vtp 1 = Vo(Fwp)(Fpp)(Fpwt)								
Fwp 2								
Fpp 2								
Fpt 2								
Fwt 2								
Fpwt = Fpt/Fwt								
Vtp = Vo(Fwp)(Fpp)(Fpwt)								

Restrained Pipe								
Vo								
Vo Restrained	40 gal	25,882 gal	200 gal	8,627 gal	124 gal	2 gal	4,200 gal	1 gal
Fwp 1	1.003163	1.003163	1.003163	1.003163	1.003163	1.003163	1.003163	1.003163
Fpp 1	1.001021	1.000779	1.000779	1.000682	1.001044	1.000232	1.001511	1.000232
Fpt 1	1.000012	1.000012	1.000012	1.000012	1.000012	1.000012	1.000012	1.000012
Fwt 1	1.000080	1.000080	1.000080	1.000080	1.000080	1.000080	1.000080	1.000080
Fpwt 1 = Fpt/Fwt	0.999932	0.999932	0.999932	0.999932	0.999932	0.999932	0.999932	0.999932
Vtp 1 = Vo(Fwp)(Fpp)(Fpwt)	41 gal	25,983 gal	201 gal	8,660 gal	125 gal	2 gal	4,219 gal	1 gal
Fwp 2	1.003163	1.003163	1.003163	1.003163	1.003163	1.003163	1.003163	1.003163
Fpp 2	1.001025	1.000783	1.000783	1.000685	1.001048	1.000235	1.001514	1.000235
Fpt 2	1.000024	1.000024	1.000024	1.000024	1.000024	1.000024	1.000024	1.000024
Fwt 2	1.000181	1.000181	1.000181	1.000181	1.000181	1.000181	1.000181	1.000181
Fpwt = Fpt/Fwt	0.999844	0.999844	0.999844	0.999844	0.999844	0.999844	0.999844	0.999844
Vtp = Vo(Fwp)(Fpp)(Fpwt)	41 gal	25,980 gal	201 gal	8,659 gal	125 gal	2 gal	4,219 gal	1 gal

Combined Pipe								
Vo								
1 °F Change								



Pipe Segment Volume Allowance Calculations

Company Pacific Gas and Electric Company
 Construction Co. ARB
 Hydro. Test Co. ARB
 Test Section PG&E T-343-14 Test 2, L-191A, MP 0.002 - 2.97
 File Name RCP J00110 - T-343-14 Test 2, L-191A, MP 0.002 - 2.97

General Pipe Data							
Description	Segment						
	17	18	19				
Restrained or Unrestrained?	Restrained	Unrestrained	Unrestrained				
Outside Diameter	1.050 in.	8.625 in.	8.625 in.				
Wall Thickness	0.113 in.	0.500 in.	0.500 in.				
Inside Diameter	0.824 in.	7.625 in.	7.625 in.				
Spec./Grade	25ksmys	API5L-Grade B	API5L-Grade B				
Length Unstrained		7 ft	7 ft				
Length Restrained	18 ft						
Temperature -- On Test	61.0 °F	67.0 °F	67.0 °F				
Temperature -- End of Test	62.0 °F	68.0 °F	68.0 °F				
Pressure -- On Test	1,032 psig	1,032 psig	1,032 psig				
Pressure -- End of Test	1,032 psig	1,032 psig	1,032 psig				
Unrestrained Pipe							
Vo							
Vo Unrestrained		15 gal	15 gal				
Fwp 1		1.003163	1.003163				
Fpp 1		1.000656	1.000656				
Fpt 1		1.000127	1.000127				
Fwt 1		1.000681	1.000681				
Fpwt 1 = Fpt/Fwt		0.999447	0.999447				
Vtp 1 = Vo(Fwp)(Fpp)(Fpwt)		15.47 gal	15.47 gal				
Fwp 2		1.003163	1.003163				
Fpp 2		1.000656	1.000656				
Fpt 2		1.000146	1.000146				
Fwt 2		1.000803	1.000803				
Fpwt = Fpt/Fwt		0.999343	0.999343				
Vtp = Vo(Fwp)(Fpp)(Fpwt)		15.47 gal	15.47 gal				
Restrained Pipe							
Vo							
Vo Restrained	0 gal						
Fwp 1	1.003163						
Fpp 1	1.000232						
Fpt 1	1.000012						
Fwt 1	1.000080						
Fpwt 1 = Fpt/Fwt	0.999932						
Vtp 1 = Vo(Fwp)(Fpp)(Fpwt)	1 gal						
Fwp 2	1.003163						
Fpp 2	1.000235						
Fpt 2	1.000024						
Fwt 2	1.000181						
Fpwt = Fpt/Fwt	0.999844						
Vtp = Vo(Fwp)(Fpp)(Fpwt)	1 gal						
Combined Pipe							
Vo							
1 °F Change							



Hydrostatic Pressure Test Pipe Data Table

Pipe Type	Length	Restrained / Unrestrained	Outside Diameter	Wall Thickness	Specification & Grade	Pipe Yield Pressure	Material	Joint Type	Seam Type	
1	101	17.98 ft	Unrestrained	8.625 in.	0.3220 in.	API5L-Grade B	2,613 psig	Steel	Arc Weld	SM
2	104	141.79 ft	Unrestrained	6.625 in.	0.2800 in.	API5L-Grade B	2,958 psig	Steel	Arc Weld	SM
3	102	2.97 ft	Unrestrained	8.625 in.	0.2500 in.	API5L-X42	2,435 psig	Steel	Arc Weld	ERW-HF
4	105	2.88 ft	Unrestrained	3.500 in.	0.2160 in.	API5L-Grade B	4,320 psig	Steel	Arc Weld	SM
5	106	9.48 ft	Unrestrained	2.375 in.	0.1540 in.	API5L-Grade B	4,539 psig	Steel	Arc Weld	SM
6	107	13.80 ft	Unrestrained	1.050 in.	0.1540 in.	API5L-Grade B	10,267 psig	Steel	Arc Weld	SM
7	101	22.90 ft	Restrained	8.625 in.	0.3220 in.	API5L-Grade B	2,613 psig	Steel	Arc Weld	SM
8	104	21.74 ft	Restrained	6.625 in.	0.2800 in.	API5L-Grade B	2,958 psig	Steel	Arc Weld	SM
9	102	15.01 ft	Restrained	8.625 in.	0.2500 in.	API5L-X42	2,435 psig	Steel	Arc Weld	ERW-HF
10	1	9,959.32 ft	Restrained	8.625 in.	0.3220 in.	API5L-X42	3,138 psig	Steel	Arc Weld	ERW-LF
11	2	76.92 ft	Restrained	8.625 in.	0.3220 in.	API5L-Grade B	2,613 psig	Steel	Arc Weld	SM
12	5	5,748.43 ft	Restrained	6.625 in.	0.2800 in.	API5L-Grade B	2,958 psig	Steel	Arc Weld	SM
13	6	78.10 ft	Restrained	6.625 in.	0.1880 in.	API5L-X42	2,384 psig	Steel	Arc Weld	ERW-LF
14	16	60.00 ft	Restrained	1.050 in.	0.1130 in.	API5L-Grade B	7,533 psig	Steel	Arc Weld	SM
15	4	1,501.12 ft	Restrained	8.625 in.	0.1720 in.	API5L-X42	1,675 psig	Steel	Arc Weld	ERW-LF
16	14	41.00 ft	Restrained	1.050 in.	0.1130 in.	28ksmys	6,027 psig	Steel	Arc Weld	FBW
17	15	18.00 ft	Restrained	1.050 in.	0.1130 in.	25ksmys	5,381 psig	Steel	Arc Weld	FBW
18	TH	6.50 ft	Unrestrained	8.625 in.	0.5000 in.	API5L-Grade B	4,058 psig	Steel	Arc Weld	SM
19	TH	6.50 ft	Unrestrained	8.625 in.	0.5000 in.	API5L-Grade B	4,058 psig	Steel	Arc Weld	SM

Hydrostatic Test Project Owner & Participants

Owner Company	Pacific Gas and Electric Company						Job Number
Address	6121 Bollinger Canyon RD San Ramon CA 94583 Attention: Mark Cabral, Aziza Tarin						41918944 Test 2 31018614 Test 2
Construction Company	ARB						Job Number
Address	1875 Lovenidge Road Pittsburg, CA 94565 Attention: T Barnes						41918944 Test 2 31018614 Test 2
Hydrostatic Test Co.	ARB						Project No.
Address	1875 Lovenidge Road Pittsburg, CA 94565						41918944 Test 2 31018614 Test 2
Test Section	PG&E T-343-14 Test 2, L-191A, MP 0.002 - 2.97						
		From:	0+00	MP 0.00			
		To:	172+37	MP 2.97			
File Name	RCP J00110 - T-343-14 Test 2, L-191A, MP 0.002 - 2.97						

Test Specifications

Test Factor	1.5	[1A]Minimum Test Pressure at Maximum Elevation	680 psig	[1B]Maximum Test Pressure at Minimum Elevation	1,120 psig
ASME B31.8S -- Integrity Assessment Interval		10 years	Desired MAOP % SMYS	16.89%	ASME B31.8S Minimum Test Factor
Spike Test	Yes	[1C]Spike Factor	1.2	[1D]Spike Pressure at Maximum Elevation	816 psig
		[1E]Spike Pressure at Minimum Elevation	1,111 psig	[1F]Max. Post-Spike Pressure at Minimum Elevation @	90%
Test Medium to Be Used		Water	Minimum Test Duration	1.00 hours	Spike Duration
					15 minutes

Test Elevation

Elevation @ Test Point	726 ft	Location	172+37	[2A]Static Head Between Test Point and Maximum Elevation	(280) psi
Maximum Elevation in Test Section	1,370 ft	Location	04+65	[2B]Static Head Between Test Point and Minimum Elevation	16 psi
Minimum Elevation in Test Section	691 ft	Location	151+09		

No Spike Test: Calculations and Test Results

Min. Required Test Press At Test Point	NA	Max. Allowable Test Press at Test Point	NA	Pressure Range During Test	NA
[2C]Minimum Test Pressure Indicated	NA	[2D]Maximum Test Pressure Indicated	NA		
Calculated Min. Test Pressure at Max. Elevation	NA	Calculated Max. Test Pressure at Min. Elevation	NA		


Spike Test: Calculations and Test Results

Spike Pressure at Test point	1,095 psig	Min. Required Test Press At Test Point	960 psig	Max. Post-Spike Pressure at Test Point	983 psig	Pressure Range After Spike Test	23 psig
[2E]Spike Pressure Indicated	1,095 psig	[2F]Minimum Test Pressure Indicated	969 psig	[2G]Max. Post-Spike Test Pressure Indicated	970 psig		
Calculated Spike Pressure at Min. Elevation	1,111 psig	Calculated Min. Test Pressure at Max. Elevation	689 psig	Calculated Max. Post Spike Pressure at Min. Elevation	986 psig		


Test Acceptance

Time and Date Test Pressure Reached	11-Nov-2014 15:43	Time and Date Test Ended	11-Nov-2014 16:48	Actual Duration of Test	1 hours 5 minutes
Hydrostatic Test Date	11-Nov-2014 15:02	Code of Federal Regulations, Title 49, Part 192, Subpart J (Class 3)			
Test Fluid Density	62.40 lb/ft ³	Pacific Gas and Electric Company's desired MAOP			283 psig
Ramp Hold Pressure	720 psig	Target Test Pressure	970 psig		

PG&E T-343-14 Test 2, L-191A, MP 0.002 - 2.97

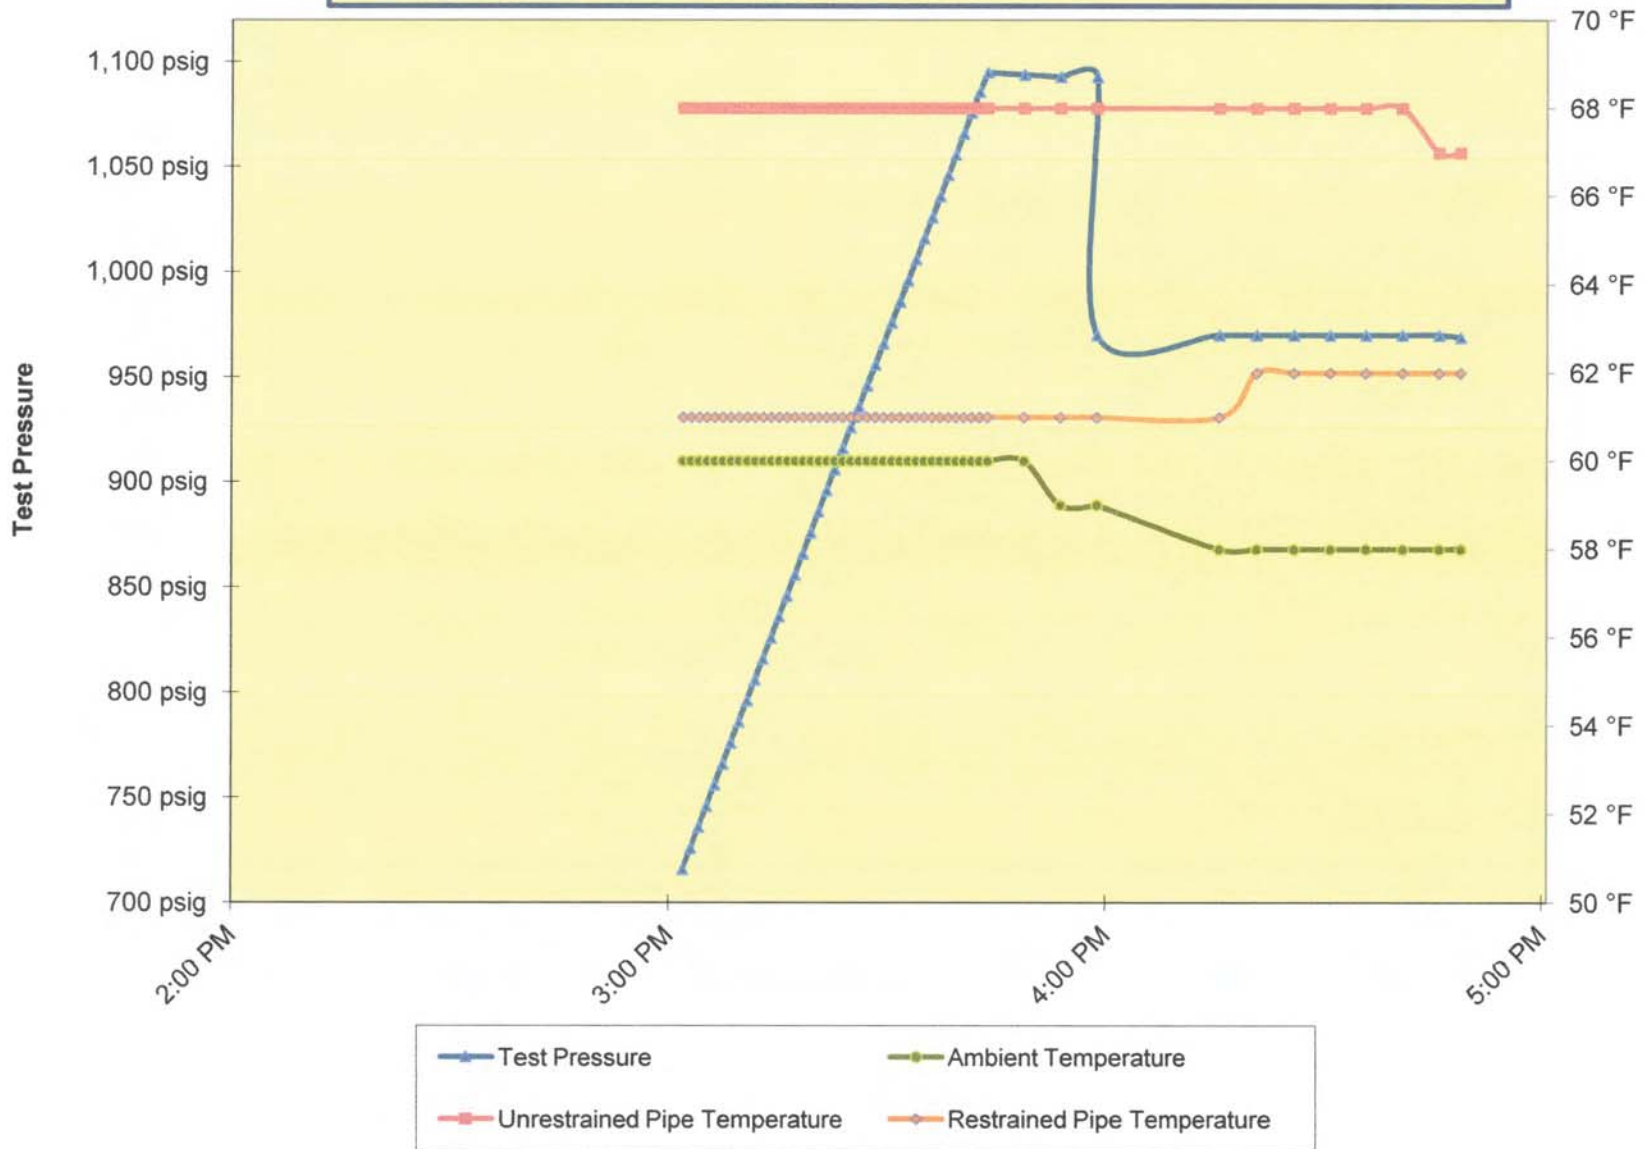

Spike Pressure Test
Stress Strain Curve -- PG&E T-343-14 Test 2, L-191A, MP
0.002 - 2.97

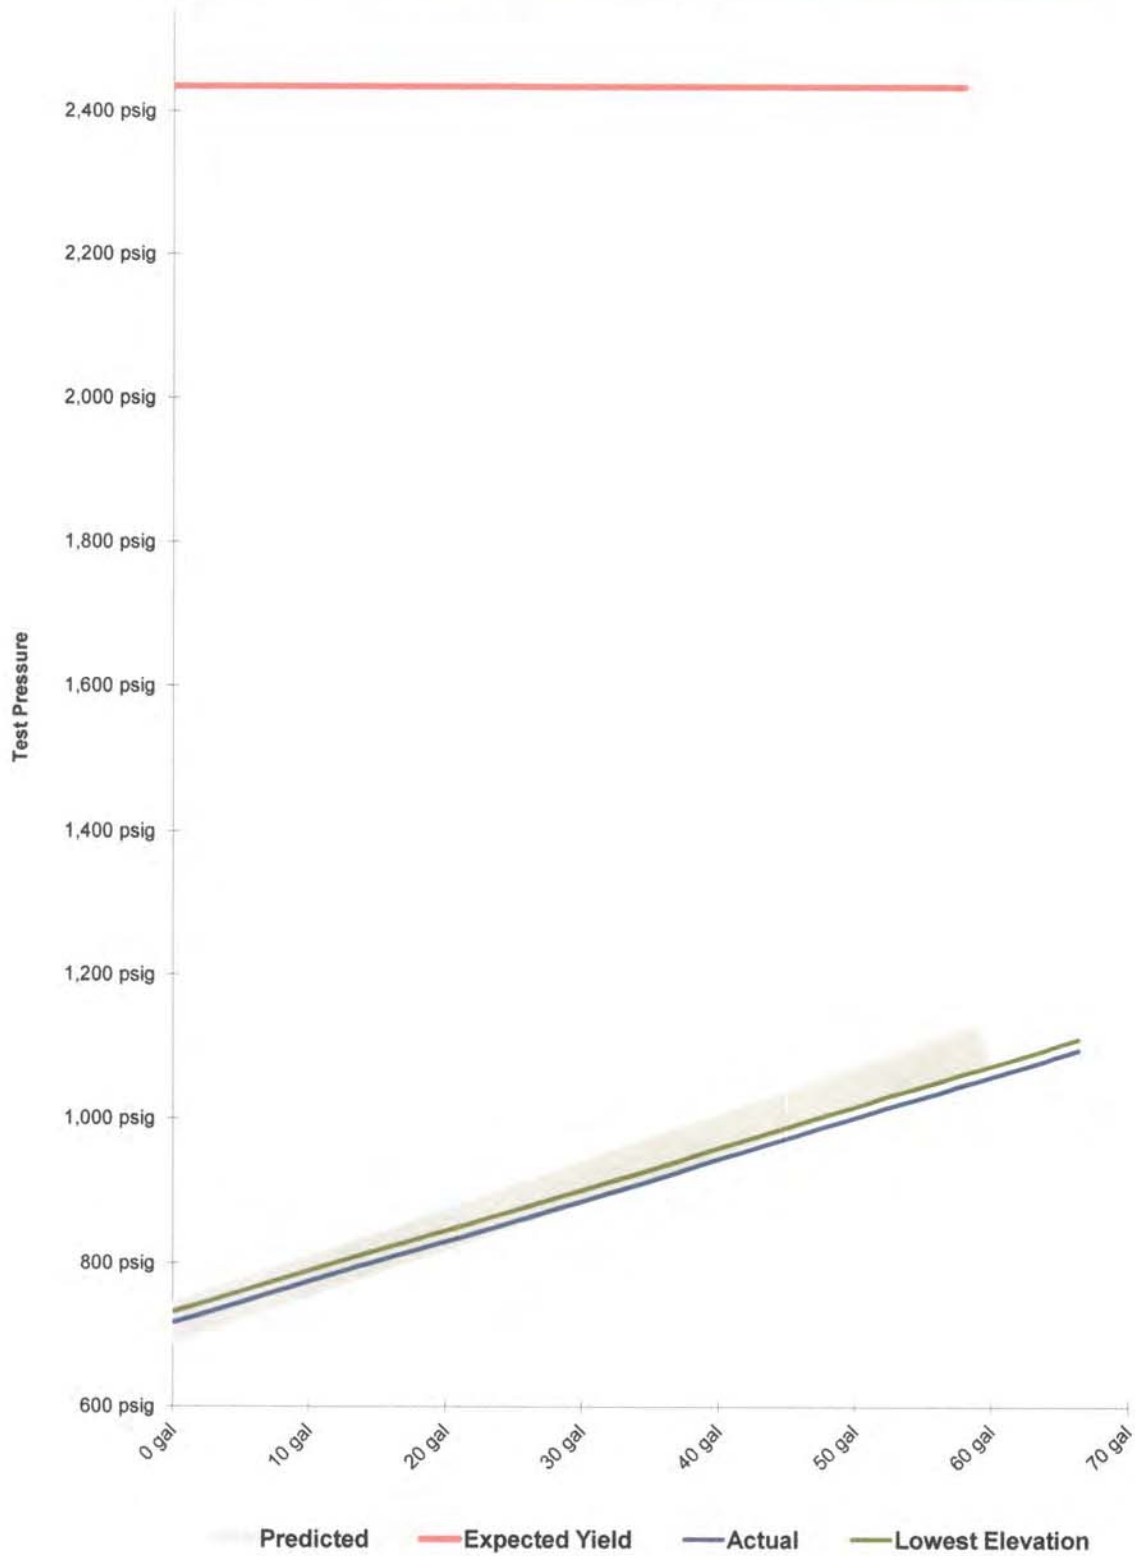



Test Head Location O



WIWA Pump



ARB Test Trailer



Frack Tanks



Deadweights



**Pressure & Ambient
Temperature Recorders**



**Restrained Temperature
Recorder**



**Unrestrained Temperature
Recorder**



Hydrostatic Test Log Sheet

Owner Company	Pacific Gas and Electric Company	Job Number	41918944 Test 2 31018614 Test 2
Construction Co.	ARB	Job Number	41918944 Test 2 31018614 Test 2
Testing Co.	ARB	Job Number	41918944 Test 2

Test Section	Name	PG&E T-343-14 Test 2, L-191A, MP 0.002 - 2.97	
		Station (0+00)	Elevation (Feet)
	Test Location	172+37	726 ft
	Begin	0+00	1,316 ft
	End	172+37	726 ft
	High Elevation	04+65	1,370 ft
Low Elevation	151+09	691 ft	

Pipe Data	Section	Length (ft.)	O. D. (in.)	W.T. (in.)	Unrestrained (ft.)	Restrained (ft.)	Grade	Seam/Joint Type
	101	18.0 ft	8.625 in.	0.322 in.	18.0 ft		API5L-Grade B	SM, Arc Weld
	104	141.8 ft	6.625 in.	0.280 in.	141.8 ft		API5L-Grade B	SM, Arc Weld
	102	3.0 ft	8.625 in.	0.250 in.	3.0 ft		API5L-X42	ERW-HF, Arc Weld
	105	2.9 ft	3.500 in.	0.216 in.	2.9 ft		API5L-Grade B	SM, Arc Weld
	106	9.5 ft	2.375 in.	0.154 in.	9.5 ft		API5L-Grade B	SM, Arc Weld
	107	13.8 ft	1.050 in.	0.154 in.	13.8 ft		API5L-Grade B	SM, Arc Weld
	101	22.9 ft	8.625 in.	0.322 in.		22.9 ft	API5L-Grade B	SM, Arc Weld
	104	21.7 ft	6.625 in.	0.280 in.		21.7 ft	API5L-Grade B	SM, Arc Weld
	102	15.0 ft	8.625 in.	0.250 in.		15.0 ft	API5L-X42	ERW-HF, Arc Weld
	1	9,959.3 ft	8.625 in.	0.322 in.		9,959.3 ft	API5L-X42	ERW-LF, Arc Weld
	2	76.9 ft	8.625 in.	0.322 in.		76.9 ft	API5L-Grade B	SM, Arc Weld
	5	5,748.4 ft	6.625 in.	0.280 in.		5,748.4 ft	API5L-Grade B	SM, Arc Weld
	6	78.1 ft	6.625 in.	0.188 in.		78.1 ft	API5L-X42	ERW-LF, Arc Weld
	16	60.0 ft	1.050 in.	0.113 in.		60.0 ft	API5L-Grade B	SM, Arc Weld
	4	1,501.1 ft	8.625 in.	0.172 in.		1,501.1 ft	API5L-X42	ERW-LF, Arc Weld
	14	41.0 ft	1.050 in.	0.113 in.		41.0 ft	28ksmys	FBW, Arc Weld
	15	18.0 ft	1.050 in.	0.113 in.		18.0 ft	25ksmys	FBW, Arc Weld
	TH	6.5 ft	8.625 in.	0.500 in.	6.5 ft		API5L-Grade B	SM, Arc Weld
	TH	6.5 ft	8.625 in.	0.500 in.	6.5 ft		API5L-Grade B	SM, Arc Weld

Test Period	Date	Time	Test Medium	Water <input checked="" type="checkbox"/>	
	Begin	11-Nov-14			15:43
	End	11-Nov-14			16:48

Test Instrumentation	Description	Calibration Checked	Serial Number	Date Calibrated / Certified	Installation Correct
	Dead Weight Pressure Tester		HL6413	3/18/2014	<input checked="" type="checkbox"/> Yes
	Pressure Recorder	<input checked="" type="checkbox"/> Yes	4346	10/16/2014	<input checked="" type="checkbox"/> Yes
	Ambient Temperature Recorder	<input checked="" type="checkbox"/> Yes	2099	8/28/2014	<input checked="" type="checkbox"/> Yes
	Restrained Pipe Temperature Recorder	<input checked="" type="checkbox"/> Yes	MFG-3011	8/28/2014	<input checked="" type="checkbox"/> Yes
Unrestrained Pipe Temperature Recorder	<input checked="" type="checkbox"/> Yes	2101	5/23/2014	<input checked="" type="checkbox"/> Yes	

Hydrostatic Test Log

Log No.	Time	Test Pressure (psig)	Temperature (°F)			Volume		Comments	Model Check: Is test good?
			Ambient	Pipe		Bleed	Inject		
				Unrestrained	Restrained				
1	11/11/14 3:43 PM	1,095 psig	60 °F	68 °F	61 °F			On Test	
2	11/11/14 3:48 PM	1,094 psig	60 °F	68 °F	61 °F				<input checked="" type="checkbox"/> Yes <input type="checkbox"/> No
3	11/11/14 3:53 PM	1,093 psig	59 °F	68 °F	61 °F				<input checked="" type="checkbox"/> Yes <input type="checkbox"/> No
4	11/11/14 3:58 PM	1,093 psig	59 °F	68 °F	61 °F				<input checked="" type="checkbox"/> Yes <input type="checkbox"/> No
5	11/11/14 3:58 PM	970 psig	59 °F	68 °F	61 °F	2,755.2 oz.			<input checked="" type="checkbox"/> Yes <input type="checkbox"/> No
6	11/11/14 4:15 PM	970 psig	58 °F	68 °F	61 °F				<input checked="" type="checkbox"/> Yes <input type="checkbox"/> No
7	11/11/14 4:20 PM	970 psig	58 °F	68 °F	62 °F				<input checked="" type="checkbox"/> Yes <input type="checkbox"/> No
8	11/11/14 4:25 PM	970 psig	58 °F	68 °F	62 °F				<input checked="" type="checkbox"/> Yes <input type="checkbox"/> No
9	11/11/14 4:30 PM	970 psig	58 °F	68 °F	62 °F				<input checked="" type="checkbox"/> Yes <input type="checkbox"/> No
10	11/11/14 4:35 PM	970 psig	58 °F	68 °F	62 °F				<input checked="" type="checkbox"/> Yes <input type="checkbox"/> No
11	11/11/14 4:40 PM	970 psig	58 °F	68 °F	62 °F				<input checked="" type="checkbox"/> Yes <input type="checkbox"/> No
12	11/11/14 4:45 PM	970 psig	58 °F	67 °F	62 °F				<input checked="" type="checkbox"/> Yes <input type="checkbox"/> No
13	11/11/14 4:48 PM	969 psig	58 °F	67 °F	62 °F			End of Test	<input checked="" type="checkbox"/> Yes <input type="checkbox"/> No

Was a leak observed during test Period? Yes No 2,755.2 oz. 0.0 oz.

If "Yes", Explain: _____ High Test Pressure: 1,095 psig
 Low Test Pressure: 969 psig

Certification:

Pacific Gas and Electric Company Field Engineer: *[Signature]* Signature

Date: 11-Nov-14



2900 Main St Alameda CA 94501 Phone (510)522-8326 Fax (510)522-3136

Certificate of Calibration

ARB, INC. PITTSBURG
1875 LOVRIDGE ROAD
PITTSBURG
CALIFORNIA 94565

Customer ID # 3773

File # 1329

Instrument Type **RECORDER,
PRESSURE**

Range 0-2000

Units PSIG

Resolution 20

Mfg. TECH-CAL

Model 1B200

Cal By **MIKE MCCONNELL
90765**

Current Cal Cycle (Months) 6

Previous Cal Cycle N/A

Standards Used **AMETEK DM-T-150 S/N 8681
DUE 3/29/2016 NIST 45204.001**

Certificate Number: **2402359**

Rated Accuracy **1%**

Pass/Fail as Found **PASS**

Pass/Fail as Left **PASS**

1st (Mfg) S/N **04346**

2nd S/N **N/A**

Cal Date **10/16/2014**

Cal Due **4/16/2015**

Notes

**TECHNICAL SERVICES GROUP CERTIFIES THAT THIS INSTRUMENT
HAS BEEN CALIBRATED TRACEABLE TO THE NATIONAL INSTITUTE
OF STANDARDS AND TECHNOLOGY AND CONFORMS TO ISO 10012
AND ANSI / NCSL Z-540. UNLESS OTHERWISE SPECIFIED
MEASUREMENT UNCERTAINTIES ARE LESS THAN 1/4 OF TOLERANCE
OR 1 MINOR DIVISION.**



CALIBRATION DATA SHEET

PRESSURE / TEMPERATURE

2900 MAIN ST ALAMEDA, CA 94501 PHONE (510) 522-8326 FAX (510) 522-3136


CUSTOMER: ARB
 MFG: TECH CAL
 RANGE: MIN 0 MAX 2,000
 TSG JOB & ITEM #: 3773
 MODEL: 1B200
 UNITS: PSIG
 RESOLUTION: 20
 RATED ACCURACY, % FULL SCALE: 1.00 %
 CERTIFICATE NO.: 2402359
 CAL BY: Mike McConnell
 CAL DATE: 10/16/2014
 MFG S/N: 04346
 CAL DUE: 4/16/2015
 2ND S/N: N/A

INSTRUMENT DISCRIPTION

PRESS. X
 TEMP. X
 VACUUM X
 CASE SIZE: RECORDER
 CONN. SIZE: N/A
 CONN. LOCATION: N/A
 THREAD TYPE: N/A
 STANDARDS USED:
 MFG. MODEL S/N RECAL N.I.S.T #
 AMATEK DM-T-150 8681 3/29/2016 4520.001
 EUTECNICS 139200-1.2 10049 8/7/2015 TE188, TE192, TE195

CALIBRATION DETAIL

% SPAN	APPLIED VALUE	OBSERVED INDICATION		ERROR		% DEVIATION		PASS / FAIL	
		AS FOUND	AS LEFT	AS FOUND	AS LEFT	AS FOUND	AS LEFT	AS FOUND	AS LEFT
0	0.00	0.00	0.00	0.00	0.00	0.00	0.00	PASS	PASS
25	500.00	500.00	500.00	0.00	0.00	0.00	0.00	PASS	PASS
50	1,000.00	1000.00	1000.00	0.00	0.00	0.00	0.00	PASS	PASS
75	1,500.00	1500.00	1500.00	0.00	0.00	0.00	0.00	PASS	PASS
100	2,000.00	2000.00	2000.00	0.00	0.00	0.00	0.00	PASS	PASS

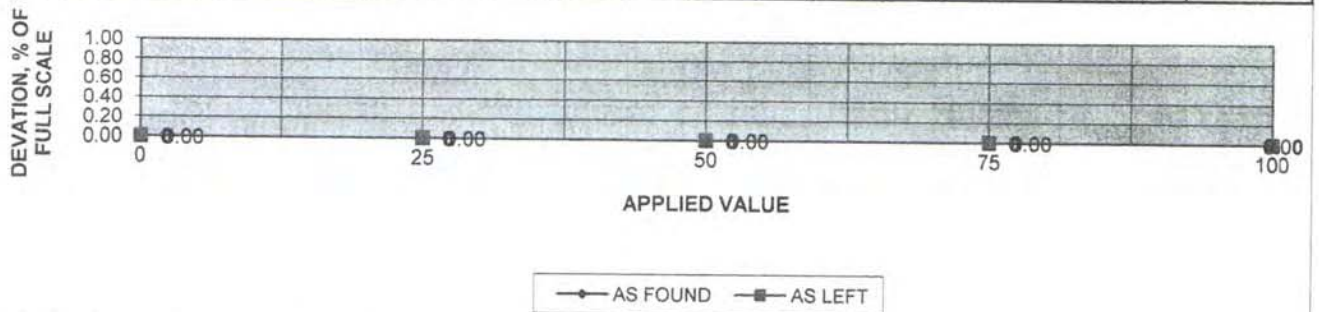

IMPACT / NOTES :

TECHNICAL SERVICES GROUP CERTIFIES THAT THIS INSTRUMENT HAS BEEN CALIBRATED TRACEABLE TO THE NATIONAL INSTITUTE OF STANDARDS & TECHNOLOGY AND CONFORMS TO ISO 10012 AND ANSI / NCSL Z-540. UNLESS OTHERWISE SPECIFIED MEASUREMENT UNCERTAINTIES ARE LESS THAN 1/4 OF TOLERANCE OR 1 MINOR DIVISION

[Signature]
 TSG CALIBRATION / Q.A. SUPERVISOR

AMBIENT

TECHNICAL SERVICES GROUP

2900 Main St Alameda CA 94501 Phone (510)522-8326 Fax (510)522-3136

Certificate of Calibration

ARB, INC. PITTSBURG
1875 LOVRIDGE ROAD
PITTSBURG
CALIFORNIA 94565

Customer ID# 3773

File # 1329

Instrument Type RECORDER,
TEMPERATURE

Range 0-150

Units DEG F

Resolution 2

Mfg TECH CAL

Model 1BT00

Cal By MIKE MCCONNELL
90765

Current Cal Cycle (Months) 6

Previous Cal Cycle 6

Standards Used FLUKE 515A SN 10520
5/29/2016 NIST F27829

Certificate Number 2402199

Rated Accuracy 1%

Pass/Fail/Out of Comp PASS

Pass/Fail/Out of Comp PASS

1st Cal by S# 02099

2nd S# TC-02

Cal Date 8/28/2014

Expire Date 2/28/2015

TECHNICAL SERVICES GROUP CERTIFIES THAT THIS INSTRUMENT
HAS BEEN CALIBRATED TRACEABLE TO THE NATIONAL INSTITUTE
OF STANDARDS AND TECHNOLOGY AND CONFORMS TO ISO 10012
AND ANSI/NCSL Z-540. UNLESS OTHERWISE SPECIFIED
MEASUREMENT UNCERTAINTIES ARE LESS THAN 1/4 OF TOLERANCE
OR 1 MINOR DIVISION.



CALIBRATION DATA SHEET PRESSURE / TEMPERATURE

2900 MAIN ST ALAMEDA, CA 94501 PHONE (510) 522-8326 FAX (510) 522-3136

CUSTOMER: ARB
 TSG JOB & ITEM #: 3773
 CERTIFICATE NO: 2402199
 CAL DATE: 8/28/2014
 CAL DUE: 2/28/2015
 MFG: TECH CAL
 MODEL: 1BT00
 CAL BY: Mike McConnell
 MFG S/N: 02098
 RANGE: MIN 0 MAX 150
 UNITS: DEG F
 RESOLUTION: 2
 RATED ACCURACY: % FULL SCALE 1.00 %
 2ND S/N: TC-02

INSTRUMENT DISCRPTION

PRESS	TEMP	VACUUM	CASE SIZE	CONN SIZE	CONN LOCATION	THREAD TYPE
	X		N/A	N/A	N/A	N/A
			STANDARDS USED			
X	MFG: AMATEK		MODEL: DM-T-160	S/N: 8681	RECAL: 3/29/2016	NIST#: 4520.001
X	MFG: FLUKE		MODEL: 615A	S/N: 10520	RECAL: 5/29/2016	NIST#: F27829

CALIBRATION DETAIL

% SPAN	APPLIED VALUE	OBSERVED INDICATION		ERROR		% DEVIATION		PASS / FAIL	
		AS FOUND	AS LEFT	AS FOUND	AS LEFT	AS FOUND	AS LEFT	AS FOUND	AS LEFT
0	0.00	0.00	0.00	0.00	0.00	0.00	0.00	PASS	PASS
25	37.50	37.00	37.00	-0.50	-0.50	-0.33	-0.33	PASS	PASS
50	75.00	75.00	75.00	0.00	0.00	0.00	0.00	PASS	PASS
75	112.50	112.00	112.00	-0.50	-0.50	-0.33	-0.33	PASS	PASS
100	150.00	150.00	150.00	0.00	0.00	0.00	0.00	PASS	PASS



IMPACT / NOTES:

TECHNICAL SERVICES GROUP CERTIFIES THAT THIS INSTRUMENT HAS BEEN CALIBRATED TRACEABLE TO THE NATIONAL INSTITUTE OF STANDARDS & TECHNOLOGY AND CONFORMS TO ISO 10012 AND ANSI / NCSL Z-540. UNLESS OTHERWISE SPECIFIED MEASUREMENT UNCERTAINTIES ARE LESS THAN 1/4 OF TOLERANCE OR MINOR DIVISION

[Signature]
 TSG CALIBRATION / Q.A. SUPERVISOR

UNRESTRAINED



TECHNICAL SERVICES GROUP

2900 Main St Alameda CA 94501 Phone (510)522-8326 Fax (510)522-3136

Certificate of Calibration

ARB, INC. PITTSBURG
1875 LOVRIDGE ROAD
PITTSBURG
CALIFORNIA 94565

Customer ID # 3773

File # 1329

Instrument Type **RECORDER,
TEMPERATURE**

Range **0-150**

Units **DEG F**

Resolution **2**

Mfg **TECHCAL**

Model **1BT00**

Cal By **J.P. 082277**

Current Cal Cycle (Months) **12**

Previous Cal Cycle **12**

Standards Used **EUTECHNICS 139200-1.2 S/N
100049 DUE 7/31/2014 NIST
TE188, TE192, TE195**

Certificate Number: **2802953**

Rated Accuracy **1%**

Pass/Fail as Found **PASS**

Pass/Fail as Left **PASS**

1st (Mfg) S N **02101**

2nd S N **N/A**

Cal Date **5/23/2014**

Cal Due **5/23/2015**

Notes

**TECHNICAL SERVICES GROUP CERTIFIES THAT THIS INSTRUMENT
HAS BEEN CALIBRATED TRACEABLE TO THE NATIONAL INSTITUTE
OF STANDARDS AND TECHNOLOGY AND CONFORMS TO ISO 10012
AND ANSI / NCSL Z-540. UNLESS OTHERWISE SPECIFIED
MEASUREMENT UNCERTAINTIES ARE LESS THAN 1/4 OF TOLERANCE
OR 1 MINOR DIVISION.**



CALIBRATION DATA SHEET

PRESSURE / TEMPERATURE

LAST REVISION: 4/16/2014

2900 MAIN ST ALAMEDA CA 94501 PHONE (510) 522-8326 FAX (510) 522-3136

CUSTOMER ARB		TSG JOB	TSG ITEM	CUST. P. O. #	SHIPPING #	DESCRIPTION: PRESS. <input type="checkbox"/> TEMP. <input checked="" type="checkbox"/> TEST GAGE	ASSIGNED G-T # 2802953
1ST SERIAL # 02101	2ND SERIAL #	MANUFACTURER Tech Cal		MODEL 1BT00	RANGE 0-150°	RESOLUTION 2	DIGITAL <input type="checkbox"/> ANALOG <input checked="" type="checkbox"/>
CASE SIZE	CONNECTION TYPE BOTTOM <input type="checkbox"/> BACK <input type="checkbox"/>	CONNECTION SIZE 1/8" <input type="checkbox"/> 1/4" <input type="checkbox"/> 1/2" <input type="checkbox"/> OTHER		THREAD TYPE NPT <input type="checkbox"/> TUBE <input type="checkbox"/> UN <input type="checkbox"/> ISO <input type="checkbox"/>	RATED ACCURACY % 1%	NIST TRACEABLE # PRESSURE: 45209.001 TEMPERATURE: TE188, TE192, TE195	
EXISTING CAL CYCLE 12 mo	CAL CYCLE UPDATE		LAST CAL DATE 1/14	CAL DATE 5-23-14	RECALIBRATE 5-23-15		
TECHNICIAN J.P.		BADGE # 082277	TEMPERATURE DEG. F 68 - 72	RELATIVE HUMIDITY % < 60 %	CALIBRATION PROCEDURE G-A1, SCP-01, SCP-02, SCP-03		

CONDITION				STANDARDS USED				TECHNICAL SERVICES GROUP CERTIFIES THAT THIS INSTRUMENT HAS BEEN CALIBRATED TRACEABLE TO NATIONAL INSTITUTE OF STANDARDS & TECHNOLOGY AND CONFORMS TO ISO 10012 AND ANSI / NCSL Z-540 UNLESS OTHERWISE SPECIFIED MEASUREMENT UNCERTAINTIES ARE LESS THAN 1/4 OF TOLERANCE OR 1 MINOR DIVISION
AS RECEIVED		AS RETURNED		MFG.	MODEL	SERIAL #	RECALIBRATE	
GOOD <input checked="" type="checkbox"/>	DAMAGED	IN TOL. <input checked="" type="checkbox"/>	OUT OF TOL.	AMETEK	DM-T-50	8681	3/29/2016	
IN TOL. <input checked="" type="checkbox"/>	OUT OF TOL.	LIMITED	B.E.R.	EUTECHNICS	4600	100049	7/31/2014	
		REPAIRED BEFORE TEST	PCS. CALIB. 1					

PARAMETER	RANGE .	STANDARD VALUE	OBSERVED INDICATION	CORRECTED INDICATION	TOLERANCE	PASS	FAIL
PRESSURE :							
PSIG	0	0	0		1%		
PSID		32	34			<input checked="" type="checkbox"/>	
PSIA		70	70			<input checked="" type="checkbox"/>	
IN Hg		150	152			<input checked="" type="checkbox"/>	
IN H2O							
OTHER							
VACUUM :							
IN Hg							
OTHER							
TEMPERATURE :							
DEG F <input checked="" type="checkbox"/>							
DEG C <input checked="" type="checkbox"/>							
OTHER							

DETERMINATION OF IMPACT / NOTES :

TSG CALIBRATION SUP. / QUALITY ASSURANCE SUP.



2900 Main St Alameda CA 94501 Phone (510)522-8326 Fax (510)522-3136

Certificate of Calibration

ARB, INC. PITTSBURG
 1875 LOVRIDGE ROAD
 PITTSBURG
 CALIFORNIA 94565

Customer ID # 3773

File # 1329

Instrument Type **RECORDER,
 TEMPERATURE**

Range **0-150**

Units **DEG F**

Resolution **2**

Mfg. **TECH CAL**

Model **1B100**

Cal By **MIKE MCCONNELL
 90765**

Curent Cal Cycle (Months) **6**

Previous Cal Cycle **12**

Standards Used **EUTECHNICS 139200-1.2 S/N
 100049 DUE 8/7/2015 NIST
 TE188, TE192, TE195**

Certificate Number: **2402318**

Rated Accuracy **1%**

Pass/Fail as Found **PASS**

Pass/Fail as Left **PASS**

1st (Mfg) S/N **02100**

2nd S/N **TC-03**

Cal Date **10/1/2014**

Cal Due **4/1/2015**

Notes

ISO 9000
 COMPLIANT

**TECHNICAL SERVICES GROUP CERTIFIES THAT THIS INSTRUMENT
 HAS BEEN CALIBRATED TRACEABLE TO THE NATIONAL INSTITUTE
 OF STANDARDS AND TECHNOLOGY AND CONFORMS TO ISO 10012
 AND ANSI / NCSL Z-540. UNLESS OTHERWISE SPECIFIED
 MEASUREMENT UNCERTAINTIES ARE LESS THAN 1/4 OF TOLERANCE
 OR 1 MINOR DIVISION.**




CALIBRATION DATA SHEET PRESSURE / TEMPERATURE

2900 MAIN ST ALAMEDA, CA 94501 PHONE (510) 522-8326 FAX (510) 522-3136

CUSTOMER	ARB		TSG JOB & ITEM #	3773	CERTIFICATE NO.	2402318	CAL DATE	10/1/2014	CAL DUE	4/1/2015
MFG.	TECH CAL		MODEL	1B100	CAL BY	Mike McConnell	MFG S/N	02100		
RANGE	MIN	MAX	UNITS	RESOLUTION	RATED ACCURACY, % FULL SCALE	2ND S/N	TC-03			
	0	150	DEG F	2	1.00 %					
INSTRUMENT DISCRPTION										
PRESS.	TEMP.	VACUUM	CASE SIZE	CONN. SIZE	CONN. LOCATION	THREAD TYPE				
	X		N/A	N/A	N/A	N/A				
STANDARDS USED										
	MFG.	MODEL	S/N	RECAL	N.I.S.T #					
X	AMATEK	DM-T-150	8681	3/29/2016	4520.001					
X	EUTECNICS	139200-1.2	10049	8/7/2015	TE188, TE192, TE195					

CALIBRATION DETAIL


% SPAN	APPLIED VALUE	OBSERVED INDICATION		ERROR		% DEVIATION		PASS / FAIL	
		AS FOUND	AS LEFT	AS FOUND	AS LEFT	AS FOUND	AS LEFT	AS FOUND	AS LEFT
	DEG F								
0	0.00	0.00	0.00	0.00	0.00	0.00	0.00	PASS	PASS
25	37.50	37.00	37.00	-0.50	-0.50	-0.33	-0.33	PASS	PASS
50	75.00	75.00	75.00	0.00	0.00	0.00	0.00	PASS	PASS
75	112.50	112.00	112.00	-0.50	-0.50	-0.33	-0.33	PASS	PASS
100	150.00	150.00	150.00	0.00	0.00	0.00	0.00	PASS	PASS

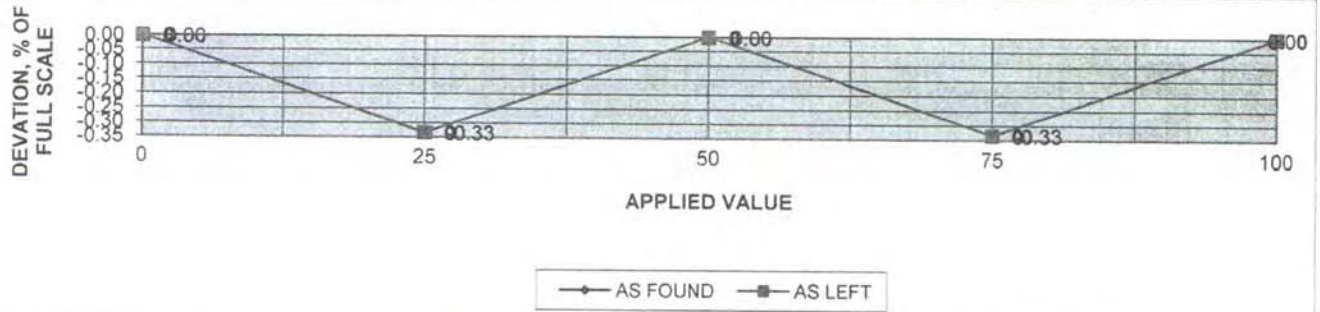

IMPACT / NOTES :

TECHNICAL SERVICES GROUP CERTIFIES THAT THIS INSTRUMENT HAS BEEN CALIBRATED TRACEABLE TO THE NATIONAL INSTITUTE OF STANDARDS & TECHNOLOGY AND CONFORMS TO ISO 10012 AND ANSI / NCSL Z-540. UNLESS OTHERWISE SPECIFIED MEASUREMENT UNCERTAINTIES ARE LESS THAN 1/4 OF TOLERANCE OR 1 MINOR DIVISION

[Signature]
TSG CALIBRATION / Q.A. SUPERVISOR



TECHNICAL SERVICES GROUP

2900 Main St Alameda CA 94501 Phone (510)522-8326 Fax (510)522-3136

Certificate of Calibration

ARB, INC. PITTSBURG
1875 LOVRIDGE ROAD
PITTSBURG
CALIFORNIA 94565

<i>Customer ID #</i>	3773	<i>Certificate Number</i>	2402200
<i>File #</i>	1329	<i>Brand Accuracy</i>	1%
<i>Instrument Type</i>	RECORDER, TEMPERATURE	<i>Pass/Fail as Found</i>	PASS
		<i>Pass/Fail as Left</i>	PASS
<i>Range</i>	0-150	<i>Lot/Mfg. S/N</i>	MFG-3011
<i>Units</i>	DEG F		
<i>Resolution</i>	2	<i>2nd S/N</i>	AC-08
<i>Mfg.</i>	CLIF-MOCK		
<i>Model</i>	N/A		
<i>Cal By</i>	MIKE MCCONNELL 90765	<i>Cal Date</i>	8/28/2014
<i>Current Cal Cycle (Months)</i>	6	<i>Exp. Date</i>	2/28/2015
<i>Previous Cal Cycle</i>	6	<i>Notes</i>	
<i>Standards Used</i>	FLUKE 515A SN 10520 5/29/2016 NIST F27829		

TECHNICAL SERVICES GROUP CERTIFIES THAT THIS INSTRUMENT HAS BEEN CALIBRATED TRACEABLE TO THE NATIONAL INSTITUTE OF STANDARDS AND TECHNOLOGY AND CONFORMS TO ISO 10012 AND ANSI / NCSL Z-540. UNLESS OTHERWISE SPECIFIED MEASUREMENT UNCERTAINTIES ARE LESS THAN 1/4 OF TOLERANCE OR 1 MINOR DIVISION.



CALIBRATION DATA SHEET PRESSURE / TEMPERATURE


2900 MAIN ST ALAMEDA, CA 94501 PHONE (510) 622-8326 FAX (510) 522-3136

CUSTOMER: ARB
 MFG: CLIF MOCK
 RANGE: MIN 0 MAX 150
 TSG JOB & ITEM #: 3773
 MODEL: N/A
 UNITS: DEG F
 RESOLUTION: 2
 RATED ACCURACY: 1.00 %
 CERTIFICATE NO.: 2402200
 CAL BY: Miké McConnell
 CAL DATE: 8/28/2014
 CAL DUE: 2/28/2015
 MFG S/N: MFG-3011
 2ND S/N: AC-08

INSTRUMENT DISCRPTION
 PRESS X TEMP VACUUM CASE SIZE RECORDER CONN. SIZE 1/4" CONN. LOCATION BACK THREAD TYPE N/A
 STANDARDS USED
 X MFG AMATEK MODEL DM-T-150 S/N 8681 RECAL 3/29/2016 NIST# 4520.001
 X MFG FLUKE MODEL 515A S/N 10520 RECAL 5/29/2016 NIST# F27829

CALIBRATION DETAIL

% SPAN	APPLIED VALUE	OBSERVED INDICATION		ERROR		% DEVIATION		PASS / FAIL	
		AS FOUND	AS LEFT	AS FOUND	AS LEFT	AS FOUND	AS LEFT	AS FOUND	AS LEFT
0	0.00	0.00	0.00	0.00	0.00	0.00	0.00	PASS	PASS
25	37.50	37.00	37.00	-0.50	-0.50	-0.33	-0.33	PASS	PASS
50	75.00	74.00	74.00	-1.00	-1.00	-0.67	-0.67	PASS	PASS
75	112.50	112.00	112.00	-0.50	-0.50	-0.33	-0.33	PASS	PASS
100	150.00	149.00	149.00	-1.00	-1.00	-0.67	-0.67	PASS	PASS

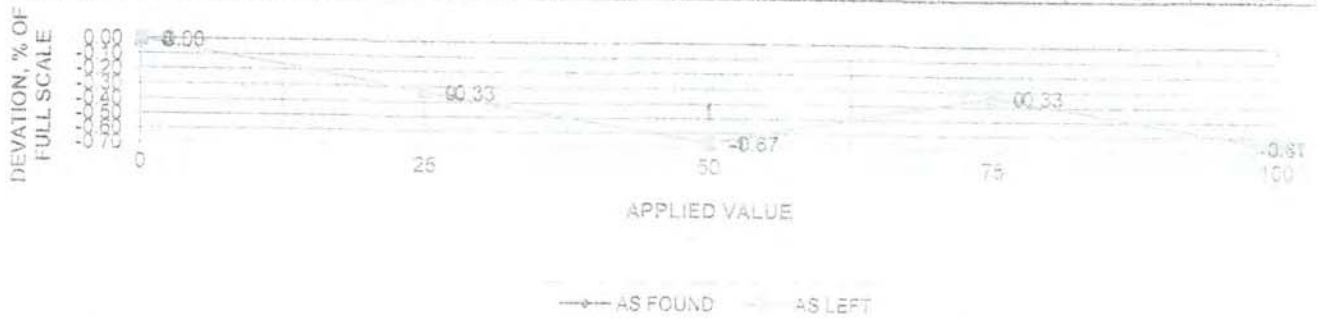

IMPACT / NOTES:

TECHNICAL SERVICES GROUP CERTIFIES THAT THIS INSTRUMENT HAS BEEN CALIBRATED TRACEABLE TO THE NATIONAL INSTITUTE OF STANDARDS & TECHNOLOGY AND CONFORMS TO ISO 10012 AND ANSI / NCSL Z-540. UNLESS OTHERWISE SPECIFIED MEASUREMENT UNCERTAINTIES ARE LESS THAN 1/4 OF TOLERANCE OR 1 MINOR DIVISION

[Signature]
 TSG CALIBRATION / QA SUPERVISOR



TECHNICAL SERVICES GROUP

2900 Main St Alameda CA 94501 Phone (510)522-8326 Fax (510)522-3136

Certificate of Calibration

ARB, INC. PITTSBURG
1875 LOVRIDGE ROAD
PITTSBURG
CALIFORNIA 94565

Customer ID # 3773

File # 1329

Instrument Type **DEAD WEIGHT
TESTER**

Range **25-3000**

Units **PSIG**

Resolution **AS RATED**

Mfg. **AMETEK**

Model **HL36**

Cal By **R.K. STRAHL**

Current Cal Cycle (Months) **12**

Previous Cal Cycle **12**

Standards Used **AMETEK DM-T-150 S/N 8681
DUE 3/3/2015 NIST 40568.001**

Certificate Number: **2802599**

Rated Accuracy **.1%**

Pass/Fail as Found **PASS**

Pass/Fail as Left **PASS**

1st (Mfg) S/N **HL6413**

2nd S/N **N/A**

Cal Date **3/18/2014**

Cal Due **3/18/2015**

Notes

**TECHNICAL SERVICES GROUP CERTIFIES THAT THIS INSTRUMENT
HAS BEEN CALIBRATED TRACEABLE TO THE NATIONAL INSTITUTE
OF STANDARDS AND TECHNOLOGY AND CONFORMS TO ISO 10012
AND ANSI / NCSL Z-540. UNLESS OTHERWISE SPECIFIED
MEASUREMENT UNCERTAINTIES ARE LESS THAN 1/4 OF TOLERANCE
OR 1 MINOR DIVISION.**



CALIBRATION DATA SHEET

PRESSURE / TEMPERATURE

LAST REVISION: 9/24/2013

2900 MAIN ST ALAMEDA CA 94501 PHONE (510) 522-8326 FAX (510) 522-3136


CUSTOMER ARB	ISG JOB 3773	ISG ITEM	CUST. P. O. #	SHIPPING # 41725	DESCRIPTION: PRESS. RECORDER	TEMP. OTHER DATA WT TDR	TEST GAGE	ASSIGNED G-T #
1ST SERIAL # HL 6413	2ND SERIAL #	MANUFACTURER AMETEK	MODEL HL 36	RANGE 25-3000	RESOLUTION	DIGITAL	ANALOG	
CASE SIZE	CONNECTION TYPE BOTTOM	CONNECTION SIZE 1/8"	THREAD TYPE NPT	RATED ACCURACY % 0.1	NIST TRACEABLE # PRESSURE: 40568001 TEMPERATURE: TE188, TE192, TE195			
EXISTING CAL. CYCLE YR	CAL. CYCLE UPDATE	LAST CAL. DATE 5/13	CAL. DATE 3/18/14	RECALIBRATE 3/18/15				

TECHNICIAN RK STRAIN	BADGE # 1502	TEMPERATURE DEG. F 68-72	RELATIVE HUMIDITY % < 60 %	CALIBRATION PROCEDURE G-A1, SCP-01, SCP-02, SCP-03
--------------------------------	------------------------	------------------------------------	---	--

CONDITION				STANDARDS USED				TECHNICAL SERVICES GROUP CERTIFIES THAT THIS INSTRUMENT HAS BEEN CALIBRATED TRACEABLE TO NATIONAL INSTITUTE OF STANDARDS & TECHNOLOGY AND CONFORMS TO ISO 10012 AND ANSI / NCSL Z.540 UNLESS OTHERWISE SPECIFIED MEASUREMENT UNCERTAINTIES ARE LESS THAN 1/4 OF TOLERANCE OR 1 MINOR DIVISION
AS RECEIVED		AS RETURNED		MFG.	MODEL	SERIAL #	RECALIBRATE	
GOOD <input checked="" type="checkbox"/>	DAMAGED <input type="checkbox"/>	IN TOL. <input checked="" type="checkbox"/>	OUT OF TOL. <input type="checkbox"/>	AMETEK	DM-T-50	8681	3/3/2015	
IN TOL. <input checked="" type="checkbox"/>	OUT OF TOL. <input type="checkbox"/>	LIMITED <input type="checkbox"/>	B.E.R. <input type="checkbox"/>	EUTECHNICS	4600	100049	7/31/2014	
		REPAIRED BEFORE TEST <input type="checkbox"/>	PCS. CALIB. <input type="checkbox"/>					

PARAMETER	RANGE	STANDARD VALUE	OBSERVED INDICATION	CORRECTED INDICATION	TOLERANCE	PASS	FAIL
PRESSURE : PSIG <input checked="" type="checkbox"/>				0.1%	0.1%	<input checked="" type="checkbox"/>	<input checked="" type="checkbox"/>
PSID <input type="checkbox"/>		500.0 PSI	500.1 PSI				
PSIA <input type="checkbox"/>							
IN Hg <input type="checkbox"/>							
IN H2O <input type="checkbox"/>		1000.0 PSI	999.9 PSI				
OTHER <input type="checkbox"/>							
VACUUM : IN Hg <input type="checkbox"/>	25-3000 PSI						
OTHER <input type="checkbox"/>		2000.0 PSI	1999.8 PSI				
TEMPERATURE : DEG F <input type="checkbox"/>		2500.0 PSI	2499.8 PSI				
DEG C <input type="checkbox"/>		3000.0 PSI	2999.7 PSI				
OTHER <input type="checkbox"/>							

DETERMINATION OF IMPACT / NOTES :

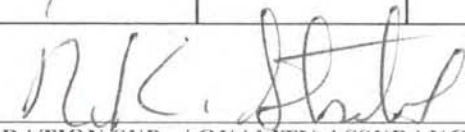
 TSG CALIBRATION SUP. / QUALITY ASSURANCE SUP.

STPR #31018614 TEST 2 OF 4 HYDROTEST TOTALS			
101	8" x 0.322", GR-B, SMLS, BARE	11.07	ft.
111	ELL 90°, 8" x 0.322", GR-B	2.00	ft.
112	ELL 45°, 8" x 0.322", GR-B	0.40	ft.
121	RED, 8" x 6", STD WT, GR-B	0.50	ft.
126	TEE, 8" x 3", STD WT, GR-B	2.34	ft.
201	8" BALL VALVE, ANSI 300	1.67	ft.
TOTAL 8" x 0.322", GR-B, SMLS		17.98	ft.

102	8" x 0.250", X-42, HFW, BARE	2.97	ft.
TOTAL 8" x 0.250", X-42, HFW		2.97	ft.

104	6" x 0.280", GR-B, SMLS, BARE	24.23	ft.
115	ELL 90°, 6" x 0.280", GR-B	8.04	ft.
116	ELL 45°, 6" x 0.280", GR-B	3.68	ft.
D	6" x 0.280", GR-B, SMLS, FBE	105.84	ft.
TOTAL 6" x 0.280", GR-B, SMLS		141.79	ft.

105	3" x 0.216", GR-B, SMLS, BARE	1.16	ft.
122	RED, 3" x 2", STD WT, GR-B	0.56	ft.
126	TEE, 8" x 3" STD, BRANCH, GR-B	1.16	ft.
TOTAL 3" x 0.216", GR-B, SMLS		2.88	ft.

106	2" x 0.154", GR-B, SMLS, BARE	9.14	ft.
C	2" COUPLING, SOCKETWELD	0.34	ft.
162	CAP, 2", SOCKETWELD, 3000#	2	ea.
TOTAL 2" x 0.154", GR-B, SMLS		9.48	ft.

107	3/4" x 0.154", GR-B, SMLS, BARE	12.34	ft.
117	ELL 45°, 3/4" x 0.154", #3000	0.96	ft.
165	NIPPLE, 3/4" x 1/2" x 3", GR-B	0.50	ft.
169	1" VALVE TEE, MUELLER	2	ea.
167	1/2" BALL VALVE	2	ea.
168	1/2" PLUG, THREADED	2	ea.
TOTAL 3/4" x 0.154", GR-B, SMLS		13.80	ft.

STPR #41918944 TEST 2 OF 4 HYDROTEST TOTALS			
101	8" x 0.322", GR-B, SMLS, BARE	14.74	ft.
111	ELL 90°, 8" x 0.322", GR-B	8.00	ft.
112	ELL 45°, 8" x 0.322", GR-B	0.16	ft.
TOTAL 8" x 0.322", GR-B, SMLS		22.90	ft.

102	8" x 0.250", X-42, HFW, BARE	15.01	ft.
TOTAL 8" x 0.250", X-42, HFW		15.01	ft.

104	6" x 0.280", GR-B, SMLS, BARE	2.86	ft.
115	ELL 90°, 6" x 0.280", GR-B	1.24	ft.
116	ELL 45°, 6" x 0.280", GR-B	1.24	ft.
161	CAP, 6" x 0.280", GR-B	0.58	ft.
D	6" x 0.280", GR-B, SMLS, FBE	15.82	ft.
TOTAL 6" x 0.280", GR-B, SMLS		21.74	ft.